#320 pd. 3-19-01

IREDELL COUNTY HEALTH DEPARTMENT

STATESVILLE 704-878-5305 MOORESVILLE 704-664-5281

IMPROVEMENT PERMIT / AUTHORIZATION TO CONSTRUCT / OPERATION PERMIT / EXISTING SYSTEM INSPECTION

PERMIT# 20-S-010 PIN# 4730-48-6343 DATE March 12, 01

OWNER OR CONTRACTOR C&S Associates II Ray Sherrill-Mid Atlantic Tech. PHONE: Business _____ Home _____

ADDRESS 4474 Lake Dr. Sherrills Ford N.C. 28673

LOCATION State Park Rd. TR into Meadow Glen TR 1st Street attend straight w/ Scotch Irish Lane

SUBDIVISION Meadow Glen BLOCK / SECTION 4 LOT 150 LOT AREA .36 38 AC SITE CLASS PS DESIGN FLOW 360gpd L.T.A.R. .05

Septic Tank: 1000 Gallons; STB 312 Date 11-25-01
Pump Tank: _____ Gallons; PT _____ Date _____
Pump Make: _____ Model _____ Serial No. _____
Nitrification Field: No Fields 1 Square Feet 900 Linear Feet 300
No Lines 3 Trench Width 36" Max Trench Bottom Depth 36"

☑ New System ☐ Repair System Type: I. II (III) IV. V
System Description: Gravity Innovative -252 Rock.
Repair System Description: LP PVC
Maintenance Agreement Required: ☐ Yes ☑ No initially
Gravel Depth NA ☐ Slab ☑ Crawl Space ☐ Basement w/plumbing ☐ Basement wo/plumbing


☑ House/Mod. Home No. Bedrooms 3
☐ Mobile Home No. Bathrooms 2
☐ Business No. Employees _____
☐ Other _____

Water Supply: ☐ Individual ☑ Public ☐ Community

Comments/Conditions: 3-20-01 Reviewed house floor plan; Appears substantially in compliance w/ initial sketch. House & Driveway to be located exactly as those shown.

Comments/Conditions: ADD 10' TO LAST 2 LINES, FIRST DITCH SILTED IN & NEEDS DUG OUT & REDONE
NEED DATE (LC) 8-1-01

INITIAL SITE SKETCH

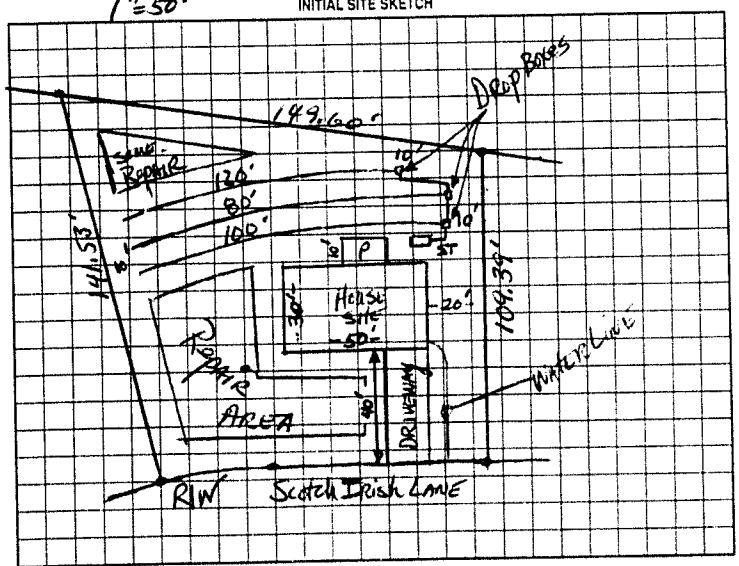

AS BUILT SKETCH

ZABEL FILTER & MARKER

① INSTALLED DURING VERY WET SOIL CONDITIONS.
② NEEDS 10' IN SECOND DITCH & 10' IN THIRD DITCH.
③ NEEDS TO DIG OUT HEAVILY SILTED FIRST LINE & COMPLETELY REDO! (BECAUSE OF RAIN)
④ DO NOT REUSE HOS SECTIONS
⑤ SHOVEL OFF TANK SO DATE CAN BE READ!
⑥ NEEDS TO GET AUTHORIZATION TO WORK IN IREDELL COUNTY
⑦ WHEN EVERYTHING IS COMPLETED CALL FOR RE-INSPECTION
⑧ DO NOT COVER WITH WET EXPOSED SOIL, LET IT DRY OUT FIRST

8-7-01 EVERYTHING COMPLETED & OK! LC
NEEDS AUTHORIZATION IN IREDELL COUNTY

Permit can be suspended or revoked if any false information is supplied toward securing the permit/any unauthorized changes are made to the site, any unauthorized changes are made in the installation of the system. Improvement Permit with plat valid without expiration. Improvement Permit with site plan valid for sixty months. Authorization to Construct is valid for a period equal to that of Improvement Permit – not to exceed sixty months.

Signed: _____ date _____
Improvement Permit by: _____ date 3-12-01
Authorization to Construct by: _____ date 3-20-01

Installed by: HOWARD'S BACKHOE
Operation Permit by: _____ date 8-7-01
Existing System Inspection by: _____ date _____

HEALTH DEPT COPY WHITE OWNER COPY (FINAL) YELLOW OWNER COPY (INITIAL) PINK