#104682

IREDELL COUNTY HEALTH DEPARTMENT

THIS PERMIT VOIDS PREVIOUS ISSUED 11-8-99

STATESVILLE 704-878-5305 MOORESVILLE 704-664-5281

IMPROVEMENT PERMIT / AUTHORIZATION TO CONSTRUCT / OPERATION PERMIT / EXISTING SYSTEM INSPECTION

PERMIT# 37-2-699 PIN# 4730-48-6413 DATE 1-10-02

OWNER OR CONTRACTOR C & S ASSOCIATES PHONE Business 704-202-4971 Home

ADDRESS 904 SALEM ST. THOMASVILLE, NC 27360

LOCATION US 21 S TR PERTH RD, TR STATE PARK RD, TR MEADOW GLEN, 4TH LOT ON RIGHT

SUBDIVISION MEADOW GLEN BLOCK / SECTION LOT 126 LOT AREA 0.3616 AC SITE CLASS PS DESIGN FLOW 360 L.T.A.R 0.30 GPD/FT²

Septic Tank: 1000 Gallons STB 825 Date 3-4-02
Pump Tank: 1000 Gallons PT 302 Date 10-2-01
Pump Make: Zoeller Model N.140 Serial No —
Nitrification Field: No Fields 1 Square Feet Eq. F/200 Linear Feet 200
No Lines FOUR Trench Width 24" Max Trench Bottom Depth 33" Gravel Depth SAND 6"

✓ New System Repair System Type I II (III) IV V VI
System Description 50% REDUCTION, PUMP
Repair System Description 50% REDUCTION, PUMP
Maintenance Agreement Required: Yes ✓No
✓ Slab ✓ Crawl Space Basement w/plumbing Basement wo/plumbing


✓ House/Mod Home No Bedrooms 3
Mobile Home No Bathrooms 2
Business No Employees
Other

Water Supply:
☐ Individual
☒ Public
☐ Community

Comments/Conditions ① INSTALL 50% REDUCTION SYSTEM USING 44 PPBPS PANELS IN FOUR EQUAL LENGTH LINES
② SEE ATTACHED SHEETS FOR PUMP AND PRESSURE MANIFOLD REQUIREMENTS

Comments/Conditions — Pressure Check - Okay, Lines Checked - Okay
— Pump Info Filed Installed 4/2/02
— Tank & Alarm Checked Okay 5/14/02
Kelton

INITIAL SITE SKETCH SCALE: 1" = 30'

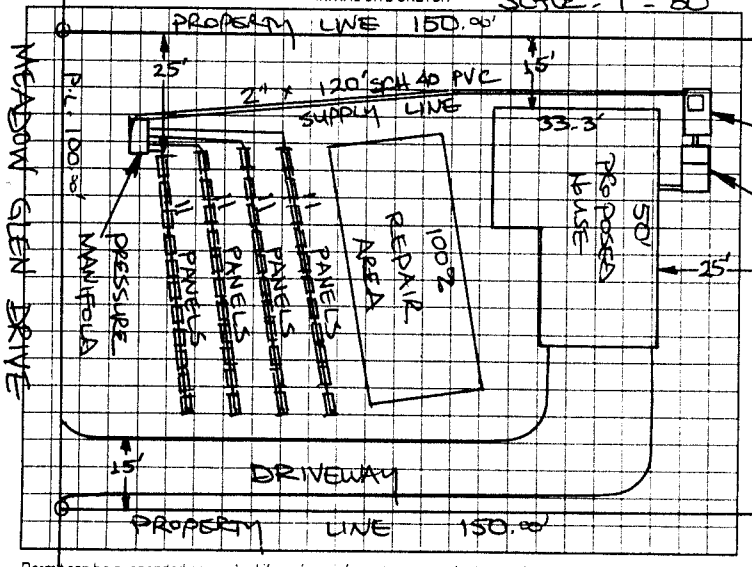

AS BUILT SKETCH

Installed

As shown per Final Site Sketch

Permit can be suspended or revoked if any false information is supplied toward securing the permit any unauthorized changes are made to the site any unauthorized changes are made in the installation of the system. Improvement Permit with plat valid without expiration. Improvement Permit with site plan valid for sixty months. Authorization to Construct is valid for a period equal to that of Improvement Permit - not to exceed sixty months.

Signed: Regina K Cecil date 1/14/02
Improvement Permit by: STEVE HEDRICK date 1-10-02
Authorization to Construct by: STEVE HEDRICK date 1-10-02

Installed by: Rowan Septic Tank + Ditching
Operation Permit by: William G Johnson date 5/14/02
Existing System Inspection by: date

HEALTH DEPT COPY WHITE OWNER COPY (FINAL) YELLOW OWNER COPY (INITIAL) PINK