IREDELL COUNTY HEALTH DEPARTMENT

STATESVILLE 704-878-5305 MOORESVILLE 704-664-5281

IMPROVEMENT PERMIT / AUTHORIZATION TO CONSTRUCT / OPERATION PERMIT / EXISTING SYSTEM INSPECTIO

(1 375.00 + 9.19

PERMIT# 04-P-0204/22378 PIN# 4730468453 4730-53-3428 DATE June 14, 04

OWNER OR CONTRACTOR Cecil-Stanley LLC PHONE: Business Home

ADDRESS 108 Westfield Plaza Mooresville N.C. 28115

LOCATION State Park Rd. TR into Meadowglen TR 1st Street TR Scotch Irish Ln. 4th Lot on Right

SUBDIVISION Meadow Glen BLOCK / SECTION LOT 135 LOT AREA .367ac SITE CLASS. 15 DESIGN FLOW 360gpd L.T.A.R. .25

Septic Tank: 1000 Gallons; STB 0825 Date 6-28-05

Pump Tank: 1000 Gallons; PT 302 Date 8-12-05

Pump Make: See As Built Sketch Model Serial No.

Nitrification Field: No Fields 1 Square Feet 480 Linear Feet 240

No Lines 3 @ 80 Trench Width 24" min Bot Max Trench Bottom Depth 36" Gravel Depth NA

☑ New System ☐ Repair System Type: I, II, III, IV, V, VI

System Description: LPP PPBPS

Repair System Description: LPP PPBPS

Maintenance Agreement Required: ☑ Yes ☐ No

☑ House/Mod. Home No. Bedrooms 3

☐ Mobile Home No. Bathrooms 2+

☐ Business No. Employees

☐ Other

☐ Slab ☑ Crawl Space ☐ Basement w/plumbing ☑ Basement wo/plumbing

Water Supply: ☐ Individual ☑ Public ☐ Communit


Comments/Conditions: INLINE filter required in pump tank ✓ DJC

Comments/Conditions:

Blue Label - Inlet filter installed

Septic tank Marker

1"=80' INITIAL SITE SKETCH

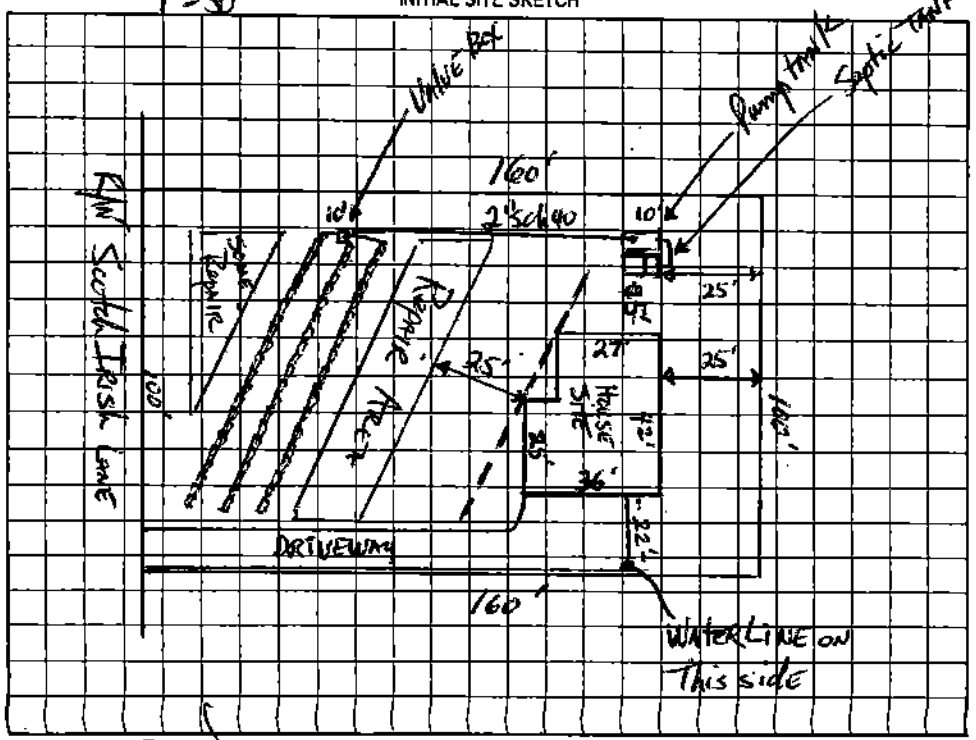

AS BUILT SKETCH

Zoeller Pump 152-5022 .4HP 8 GPM

Picked lines Pump tank + Septic tank and Please Supply manifold 2" to 2" Ball Valves

9-23-05

9-26-05 - LC

NEEDS CONTRACT

GOT CONTRACT 9-04 LC

Permit can be suspended or revoked if any false information is supplied toward securing the permit/any unauthorized changes are made to the site/any unauthorized changes are made in the installation of the system. Improvem

Permit valid for [illegible] from date of Improvement Permit with the provision that it may not be valid for sixty months if [illegible] is not to be issued prior to that of Improvement Permit – not to exceed sixty months.

9-23-05