THIS PERMIT VOIDS PRIOR PERMIT ISSUED ON 9/1/99.

IREDELL COUNTY HEALTH DEPARTMENT (93793) STATESVILLE 704-878-5305 MOORESVILLE 704-664-5281

IMPROVEMENT PERMIT / AUTHORIZATION TO CONSTRUCT / OPERATION PERMIT / EXISTING SYSTEM INSPECTION

PERMIT# 382699 PIN# 4730486913 DATE 01-26-01

OWNER OR CONTRACTOR CDS ASSOCIATES PHONE: Business 361-7518 ~~Home~~ BUILDER 902-9000

ADDRESS 607 ANDERSON AVENUE, SALISBURY

LOCATION PERTH RD SOUTH, TR STATE PARK, TR MEADOW GLENN DRIVE, 3RD ON RIGHT

SUBDIVISION MEADOW GLENN BLOCK / SECTION 1 LOT 127 LOT AREA .3579AC SITE CLASS PS DESIGN FLOW 360GPD L.T.A.R. .3

Septic Tank: 1000 Gallons: STB 825 Date 2/17/01

Pump Tank: 1000 Gallons: PT 302 Date 3/3/01

Pump Make: ZOELLER Model N137-C Serial No 137-0002

Nitrification Field: No Fields 1 Square Feet 60 to 200 Linear Feet 200

No Lines 4 Trench Width 36" Max Trench Bottom Depth 30" Gravel Depth N/A

[X] New System [ ] Repair System Type: I. II. III. IV. V. VI

System Description: PUMP PANEL

Repair System Description: PUMP PANEL

Maintenance Agreement Required: [ ] Yes [X] No

[X] House/Mod. Home No. Bedrooms 3

[ ] Mobile Home No. Bathrooms 2

[ ] Business No. Employees

[ ] Other


[ ] Slab [X] Crawl Space [ ] Basement w/plumbing [ ] Basement wo/plumbing

Water Supply: [ ] Individual [X] Public [ ] Community


Comments/Conditions: ① INSTALL LINES ON CONTOUR
② KEEP H2O LINE 10' FROM SYSTEM

Comments/Conditions: 4/24/01 - CHECKED DRAINLINES AND PUMP, NEED ELECTRICAL INSPECTION

INITIAL SITE SKETCH

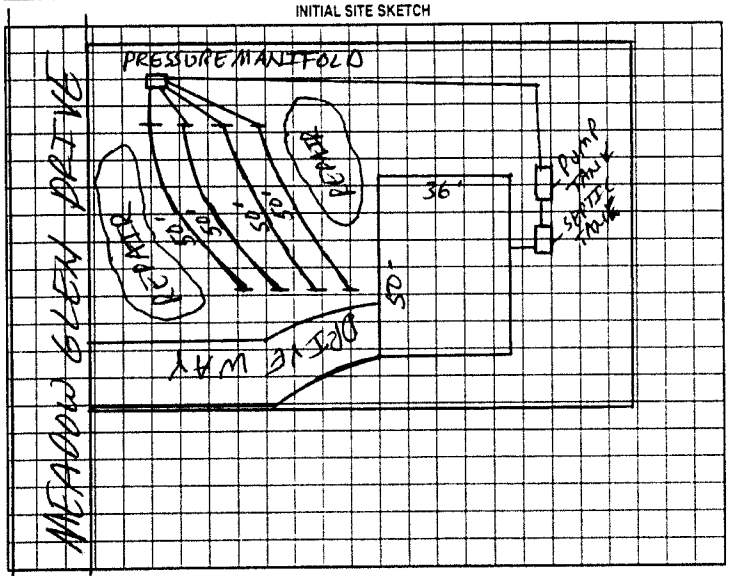

AS BUILT SKETCH

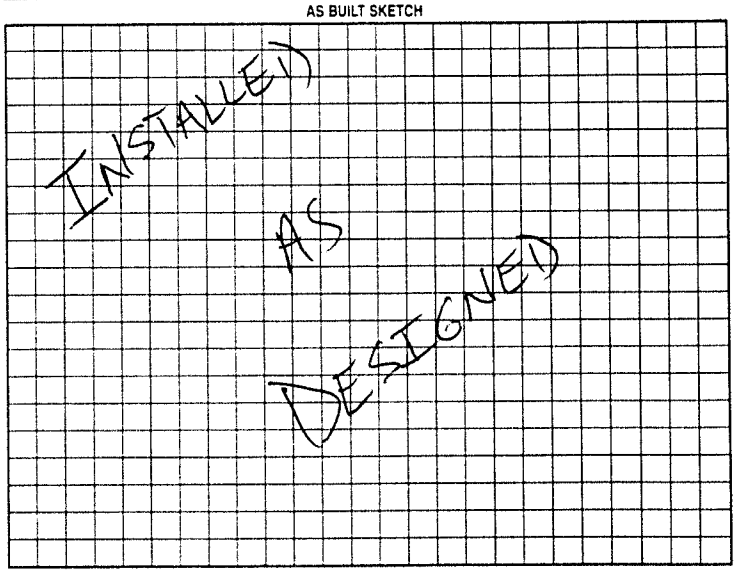

Permit can be suspended or revoked if any false information is supplied toward securing the permit; any unauthorized changes are made to the site; any unauthorized changes are made in the installation of the system. Improvement Permit with plat valid without expiration. Improvement Permit with site plan valid for sixty months. Authorization to Construct is valid for a period equal to that of Improvement Permit – not to exceed sixty months.

Signed: Jeanne S. Kerr date 2-26-01 Installed by: ROWAN SEPTIC

Improvement Permit by: Jan Cook REHS date 01-26-01 Operation Permit by: STEVE HENRICK date 5-22-01

Authorization to Construct by: Jan Cook REHS date 01-26-01 Existing System Inspection by: _____ date _____

HEALTH DEPT COPY WHITE OWNER COPY (FINAL) YELLOW OWNER COPY (INITIAL) PINK