IREDELL COUNTY HEALTH DEPARTMENT
IMPROVEMENT PERMIT / AUTHORIZATION TO CONSTRUCT / OPERATION PERMIT / EXISTING SYSTEM

DATE 4-26-06

PERMIT# 127538 PIN# 4730-58-5303

OWNER OR CONTRACTOR CECIL STAMEY LLC PHONE: Business 704-400-9673 Home 704-528-1969

ADDRESS 108 WESTFIELD CT, MOORESVILLE, NC 28115

LOCATION STATE PARK ROAD TO MEADOW GLEN, TR 1ST STREET, TR SCOTCH IRISH LANE LOT ON RIGHT NEAR END

SUBDIVISION MEADOW GLEN BLOCK / SECTION 4 LOT 133 LOT AREA 0.359 ACRE SITE CLASS. PS DESIGN FLOW 360 L.T.A.R. 0.30 GPD/FT²

Septic Tank: 1000 Gallons; STB 1012 Date 10-1-05

Pump Tank: 1000 Gallons; PT 17 Date 2-13-06

Pump Make: GOULDS Model WE05511H Serial No. 565400610

Nitrification Field: No Fields 1 Square Feet 1200 Linear Feet 200

No Lines THREE Trench Width 24" Max Trench Bottom Depth 36" Gravel Depth SAND 24"

☑ New System ☐ Repair System Type: I, II, III, IV, V, VI

System Description: 50% REDUCTION, LOW-PRESS

Repair System Description: 50% REDUCTION, LOW-PRESS

Maintenance Agreement Required: ☑ Yes ☐ No

☑ House/Mod. Home ☐ Mobile Home ☐ Business ☐ Other

No. Bedrooms 3 No. Bathrooms ___ No. Employees ___


☐ Slab ☐ Crawl Space ☑ Basement w/plumbing ☐ Basement wo/plumbing

Water Supply: ☐ Individual ☑ Public ☐ Community


Comments/Conditions: ① SEE ATTACHED EASEMENT FOR SEPTIC TANK & DRAINFIELD HORIZONTAL SETBACK EXCEPTIONS ② RELOCATE WATER LINE TO RIGHT SIDE OF DRIVEWAY ③ INSTALL 50% REDUCTION SYSTEM USING 46 PPBPS PANELS (SEE ATTACHED SHEETS)

Comments/Conditions: A CONTRACT SHALL BE EXECUTED BETWEEN THE SYSTEM OWNER & A MANAGEMENT ENTITY PRIOR TO ISSUANCE OF OPERATION PERMIT

INITIAL SITE SKETCH

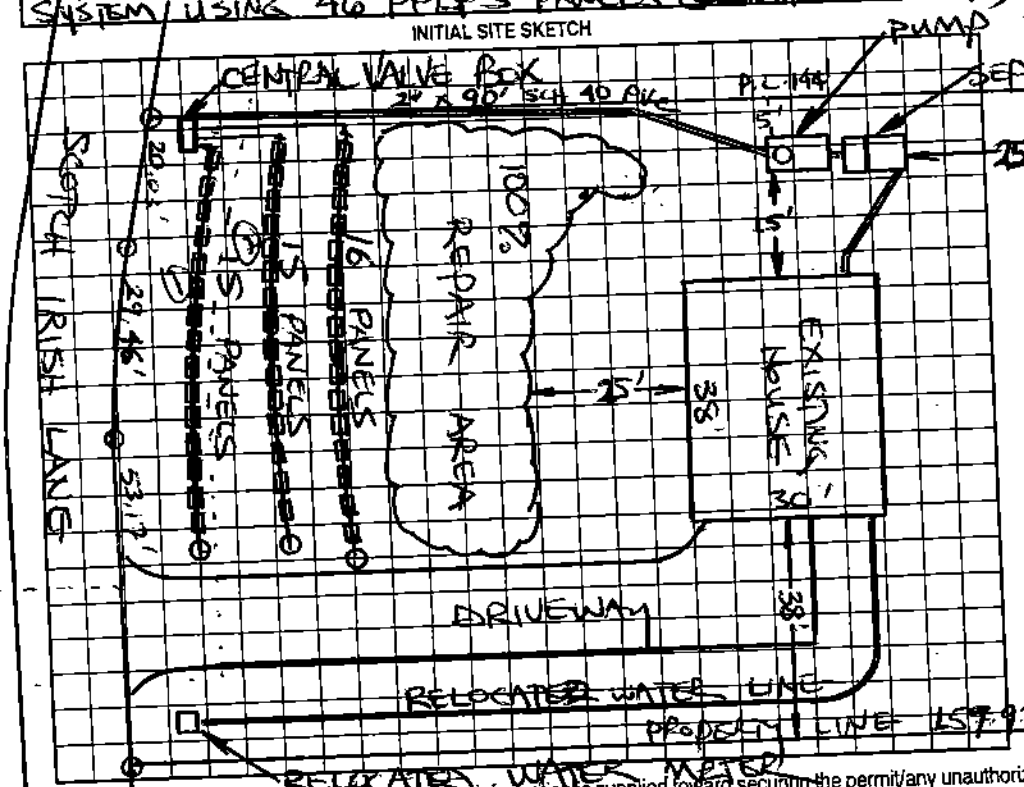

AS BUILT SKETCH

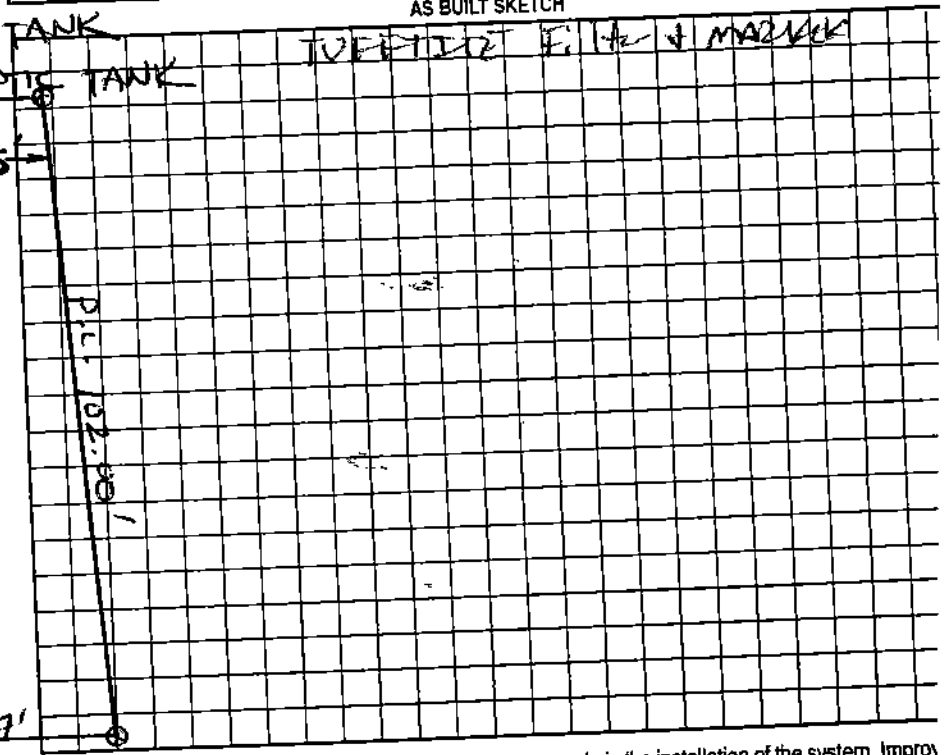

Permit can be suspended or revoked if any false information is supplied toward securing the permit/any unauthorized changes are made to the site/any unauthorized changes are made in the installation of the system. Improv

Permit with plat valid without expiration. Improvement Permit with site plan valid for sixty months. Authorization to Construct is valid for a period equal to that of Improvement Permit – not to exceed sixty months.

Signed: Jessi R. Hillis, Agent date 5-11-06

Improvement Permit by: STEVE HEDRICK date 4-26-06

Authorization to Construct by: STEVE HEDRICK date 4-26-06

Installed by: Robbie Brown 9-2-05

Operation Permit by: [signature] date 9-27

Existing System Inspection by: ___ date ___

HEALTH DEPT. COPY: WHITE OWNER COPY (FINAL): YELLOW OWNER COPY (INITIAL): PINK