100360

IREDELL COUNTY HEALTH DEPARTMENT

STATESVILLE 704-878-5305 50.00 Paid MOORESVILLE 704-664-5281

IMPROVEMENT PERMIT / AUTHORIZATION TO CONSTRUCT / OPERATION PERMIT / EXISTING SYSTEM INSPECTION

PERMIT# 17-S-010 PIN# 4730-48-6343 DATE April 27, 01

OWNER OR CONTRACTOR C4S Associates // Ginger Cecil PHONE: Business 202-4991 Home

ADDRESS 4494 Lake Dr. Sherrills Ford, N.C. 28673

LOCATION State Park Rd. TR into Meadow Glen TR 1st Street TL Scotch Irish on Right

SUBDIVISION Meadow Glen BLOCK / SECTION LOT 147 LOT AREA .5381 Ac SITE CLASS PS DESIGN FLOW 360gpd L.T.A.R. .3

Septic Tank: 1000 Gallons: STB 825 Date 4-17-01
Pump Tank: Gallons: PT Date
Pump Make: Model Serial No
Nitrification Field: No Fields 1 Square Feet 900 Linear Feet 300
No Lines 3 Trench Width 36" Max Trench Bottom Depth 36"

☑ New System ☐ Repair System Type: I. II (III) IV. V. VI
System Description: Gravity Innovative - 25% Red.
Repair System Description: LPP Innovative or PPBRS
Maintenance Agreement Required: ☐ Yes ☑ No initially
Gravel Depth N/A ☐ Slab ☐ Crawl Space ☑ Basement w/plumbing ☐ Basement wo/plumbing


☑ House/Mod. Home ☐ Mobile Home ☐ Business ☐ Other
No. Bedrooms 3 No. Bathrooms 2 No. Employees

Water Supply: ☐ Individual ☑ Public ☐ Community

Comments/Conditions:

Comments/Conditions: SEPTIC TANK WITH MARKER INSTALLED USING "POLYLOK" FILTER

INITIAL SITE SKETCH

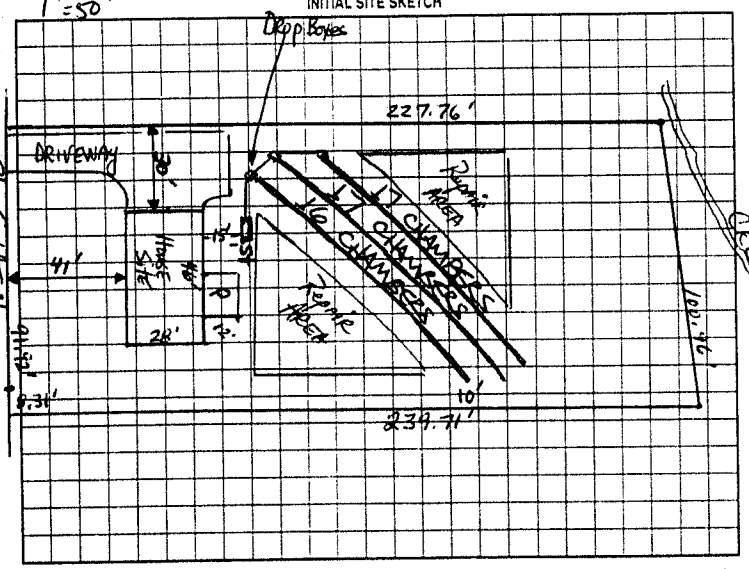

AS BUILT SKETCH

SYSTEM INSTALLED ACCORDING TO INITAL SITE SKETCH USING FIFTY (50) "INFILTRATOR" CHAMBERS

Permit can be suspended or revoked if any false information is supplied toward securing the permit/any unauthorized changes are made to the site/any unauthorized changes are made in the installation of the system. Improvement Permit with plat valid without expiration. Improvement Permit with site plan valid for sixty months. Authorization to Construct is valid for a period equal to that of Improvement Permit – not to exceed sixty months.

Signed: [signature] date 4/27/01 Installed by: ROWAN SEPTIC TANK

Improvement Permit by: [signature], RS date 4-27-01 Operation Permit by: STEVE HENDRICK date 6-19-01

Authorization to Construct by: [signature], RS date 4-27-01 Existing System Inspection by: date

HEALTH DEPT. COPY WHITE OWNER COPY (FINAL) YELLOW OWNER COPY (INITIAL) PINK