$300 pd 3-19-01

IREDELL COUNTY HEALTH DEPARTMENT

STATESVILLE 704-878-5305 MOORESVILLE 704-664-5281

IMPROVEMENT PERMIT / AUTHORIZATION TO CONSTRUCT / OPERATION PERMIT / EXISTING SYSTEM INSPECTION

PERMIT# 18-S-010 PIN# 4730-48-6343 DATE March 15, 01

OWNER OR CONTRACTOR C&S Associates II Ray Short - Mid Atlantic Bld PHONE: Business 202-4971 Home

ADDRESS 4474 Lake Dr. Sherrills Ford N.C. 28673

LOCATION State Park Rd. TR Meadowglen TR 1st Street TL Scotch Irish on Right

SUBDIVISION Meadowglen BLOCK / SECTION 4 LOT 148 LOT AREA .4886 SITE CLASS PS DESIGN FLOW 360gpd L.T.A.R. .3

Septic Tank: 1000 Gallons: STB 794 Date 4-17-01
Pump Tank: Gallons: PT Date
Pump Make: Model Serial No.
Nitrification Field: No Fields 1 Square Feet 900 Linear Feet 300
No Lines 3 Trench Width 36" Max Trench Bottom Depth 36"

☑ New System ☐ Repair System Type: I. II (III) IV. V. VI
System Description: Gravity Innovative - 25% Red.
Repair System Description: Gravity/pumped Innovative
Maintenance Agreement Required: ☐ Yes ☑ No
Gravel Depth NA ☐ Slab ☑ Crawl Space ☐ Basement w/plumbing ☐ Basement wo/plumbing


☑ House/Mod. Home No. Bedrooms 3
☐ Mobile Home No. Bathrooms 2
☐ Business No. Employees
☐ Other

Water Supply: ☐ Individual ☑ Public ☐ Community

Comments/Conditions: 3-20-01 Received house floor plan, appears substantially in compliance w/ IP sketch, House and driveway to be located exactly where shown.

Comments/Conditions: NEEDS 20' MORE FEET ON LAST LINE & FIRST LINE
① BD @ 50 + 20 = 300'
② BD
③ 7D ZABEL FILTER & MARKER

INITIAL SITE SKETCH

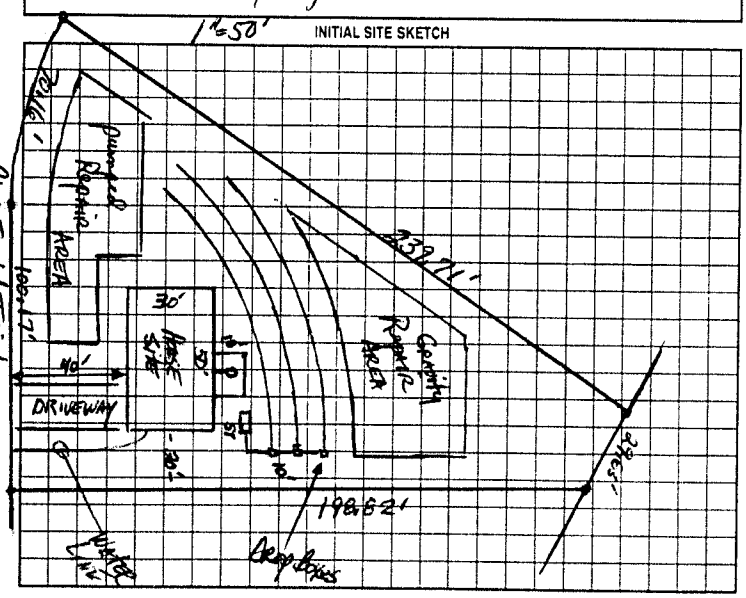

AS BUILT SKETCH

① INSTALLED DURING WET SOIL CONDITIONS
② NEED TO ADD 10' TO FIRST DITCH & 10' TO LAST DITCH
③ NEEDS Authorization to WORK IN IREDELL COUNTY
④ WHEN EVERYTHING IS COMPLETED CALL FOR RE-INSPECTION LC 8-1-01

EVERYTHING CHECKED OUT OK LC 8-7-01
NEEDS AUTHORIZATION IN IREDELL COUNTY

Permit can be suspended or revoked if any false information is supplied toward securing the permit/any unauthorized changes are made to the site/any unauthorized changes are made in the installation of the system. Improvement Permit with plat valid without expiration. Improvement Permit with site plan valid for sixty months. Authorization to Construct is valid for a period equal to that of Improvement Permit – not to exceed sixty months.

Signed: LaVerne Stamy date

Improvement Permit by: Wayne Williamson, RS date 3-15-01

Authorization to Construct by: Wayne Williamson RS date 3-20-01

Installed by: HOWARD'S BACKHOE

Operation Permit by: Jim Cook RS date 8-7-01

Existing System Inspection by: date

HEALTH DEPT. COPY WHITE OWNER COPY (FINAL) YELLOW OWNER COPY (INITIAL) PINK