IREDELL COUNTY HEALTH DEPARTMENT

STATESVILLE 704-878-5305 MOORESVILLE 704-664-5281

IMPROVEMENT PERMIT / AUTHORIZATION TO CONSTRUCT / OPERATION PERMIT / EXISTING SYSTEM INSPECTION

PERMIT# 29531 PIN# 4730602361

OWNER OR APPLICANT Macc Bldrs DATE 5-20-08

ADDRESS PHONE: Business (704) 226-8099 Home

LOCATION Perth Rd N TL into Winding Forest take to end TR Winding Shore on right

SUBDIVISION Winding Forest BLOCK / SECTION LOT 16 LOT AREA .727 Acre SITE CLASS. PS DESIGN FLOW 480 L.T.A.R. .25

Septic Tank: 1000 Gallons: STB 825 Date 4/20/08

Pump Tank: 1000 Gallons: PT 302 Date 3/15/08

Pump Make: Zoeller Model N152 Serial No.

Nitrification Field: No Fields 1 Square Feet Linear Feet 480'

No Lines 6 Trench Width Max Trench Bottom Depth Gravel Depth

☒ New System ☐ Repair ☐ Expansion System Type: I II III IV V VI

System Description: Pump-PM-25% Reduction

Repair System Description: Pump Panel Rplc

Maintenance Agreement Required: ☐ Yes ☒ No Not Initially

☒ House/Mod. Home ☐ Mobile Home ☐ Business ☐ Other

No. Bedrooms 4 No. Persons No. Employees

Water Supply: ☐ Individual ☐ Public ☒ Community

☐ Gravity ☐ Pressure ☐ Slab ☐ Crawl Space ☐ Basement w/plumbing ☐ Basement wo/plumbing


Comments:/Conditions: Water Line lengths must be as shown (within 10% of each other) to be on Pressure Manifold (PM)

Comments:/Conditions: Keep Drainfield out of Old Road Bed


Blue Filter tanks, lines & Pressure checked 6/4/08 RM

Alarm Checked 10/15/08 RM

INITIAL SITE SKETCH Scale 1:50

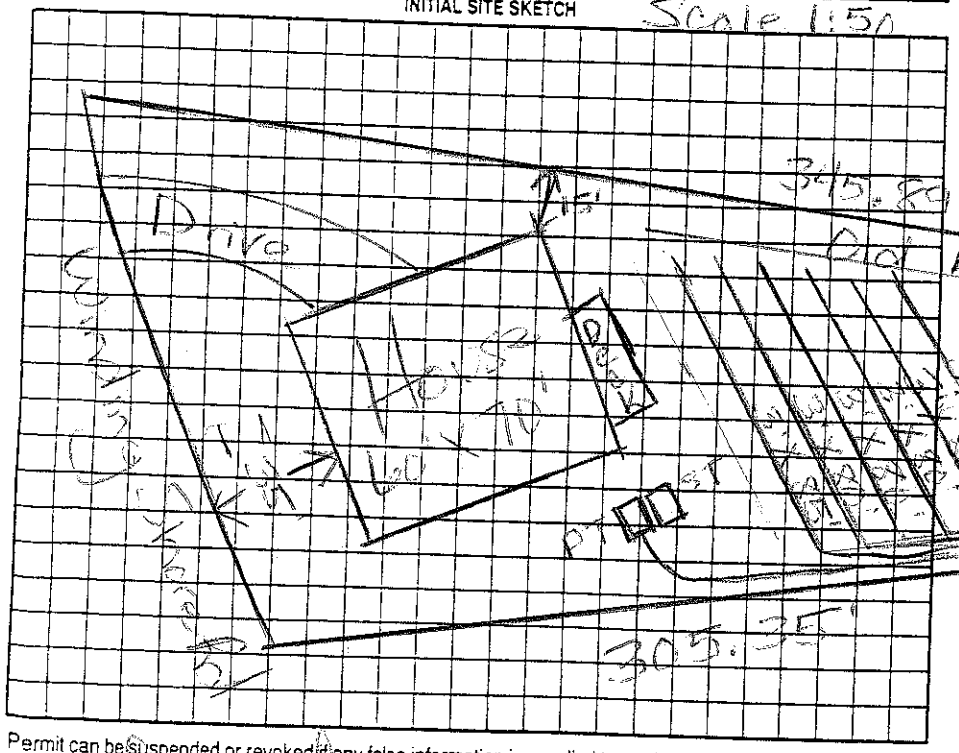

AS BUILT SKETCH

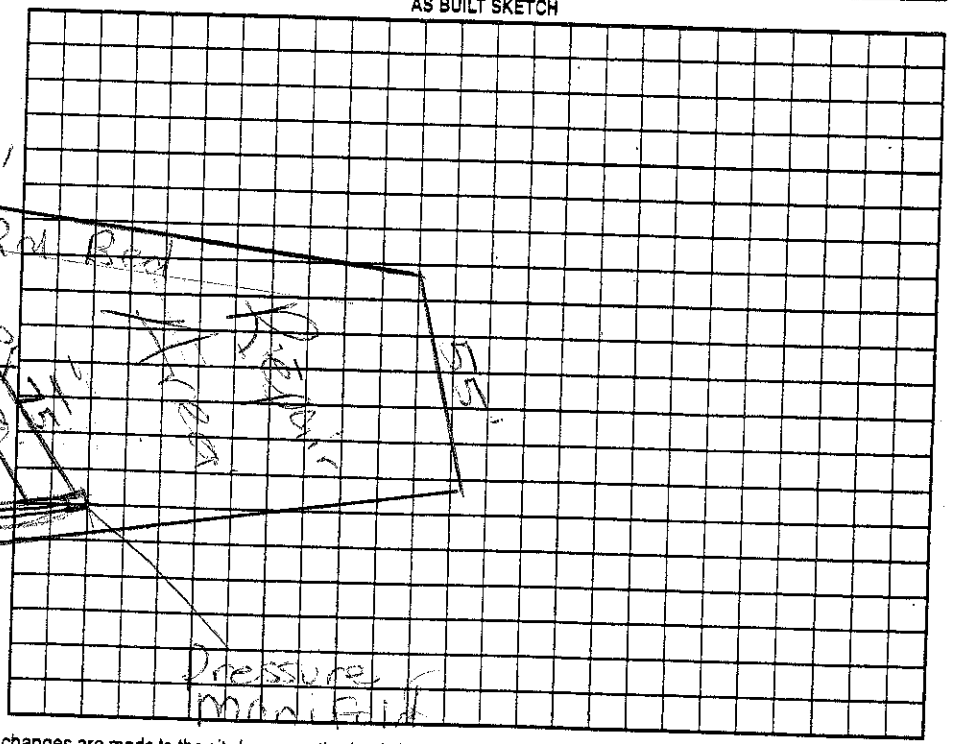

Permit can be suspended or revoked if any false information is supplied toward securing the permit/any unauthorized changes are made to the site/any unauthorized changes are made in the installation of the system. Improvement Permit with plat valid without expiration ☐ Improvement Permit with site plan valid for sixty months ☐ Authorization to Construct is valid for a period equal to that of Improvement Permit – not to exceed sixty months.

Signed: date 5-20-08 Installed by: Rowan

Improvement Permit by: Marian H. Evans RS date 5/20/08 Operation Permit by: date 10/15/08

Authorization to Construct by: Marian H. Evans RS date 5/20/08 Existing System Inspection by: date

HEALTH DEPT. COPY: WHITE OWNER COPY (FINAL): YELLOW OWNER COPY (INITIAL): PINK