11:00-11:30am

IREDELL COUNTY HEALTH DEPARTMENT

STATESVILLE 704-878-5305 MOORESVILLE 704-664-5281

IMPROVEMENT PERMIT / AUTHORIZATION TO CONSTRUCT / OPERATION PERMIT / EXISTING SYSTEM INSPECTION

PERMIT# 129580 PIN# ~~4730705378.044~~ 4730 60 5334 DATE 4-30-07

OWNER OR APPLICANT Anaheim Homes PHONE: Business 896-3200 Home

ADDRESS P.O. Box 610 Cornelius, NC 28031-0610

LOCATION Perth Rd North to Winding Forest (just past Neill Farm Rd) TR Crooked Branch on left

SUBDIVISION Winding Forest BLOCK / SECTION LOT 41 LOT AREA .6 Acre SITE CLASS. PS DESIGN FLOW 450 gpd L.T.A.R. .25

Septic Tank: 1000 Gallons; STB 1012 Date 1-30-07

Pump Tank: 1000 Gallons; PT Date 7-23-07

Pump Make Gould Model WE0 112H Serial No.

Nitrification Field/No. Fields 1 Square Feet 960 Linear Feet 320

No. Lines 5 6 Trench Width X 36" Max Trench Bottom Depth Gravel Depth ☐ Gravity ☒ Pressure ☐ Slab ☒ Crawl Space ☐ Basement w/plumbing ☐ Basement wo/plumbing

☒ New System ☐ Repair ☐ Expansion System Type: I II III (IV) V VI

System Description: LL-Panel Block

Repair System Description: Same

Maintenance Agreement Required: ☒ Yes ☐ No

☒ House/Mod. (Home) No. Bedrooms 4

☐ Mobile Home No. Persons

☐ Business No. Employees


☐ Other

Water Supply: ☐ Individual ☐ Public ☒ Community


Comments/Conditions: X Trench width per approved plan by Michael Athanas & Assoc.

Comments/Conditions: Use backfill to create slope/drain away from house. 10/18/07 Checked tanks & lines

Scale 1:50 INITIAL SITE SKETCH

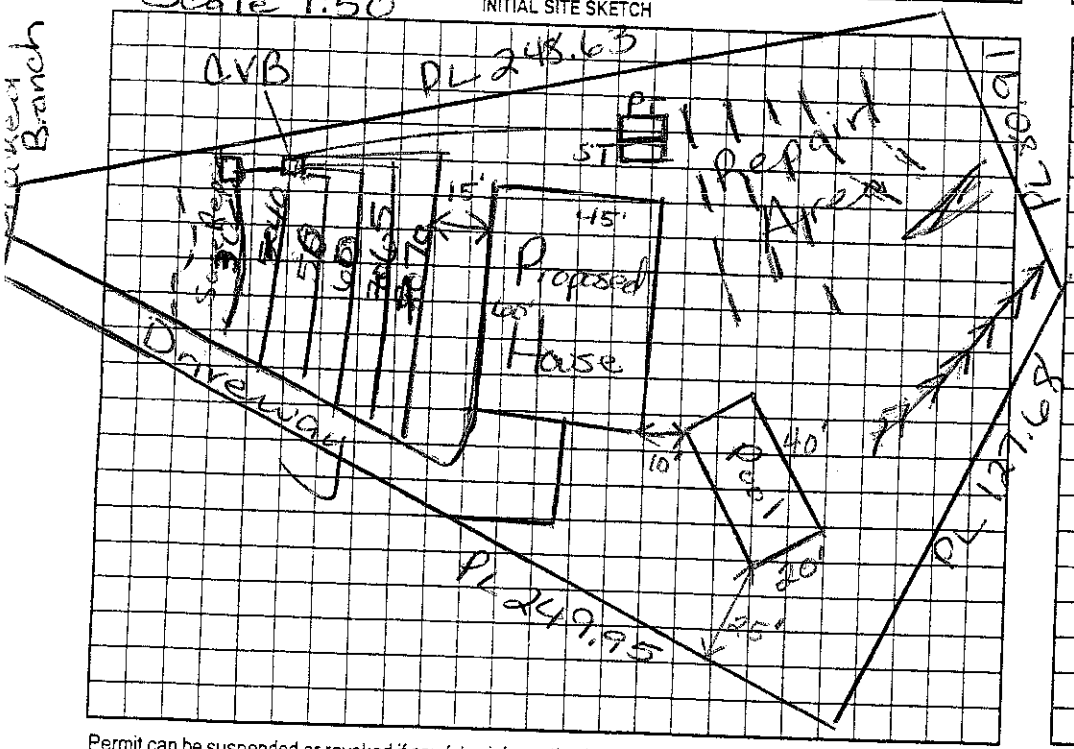

AS BUILT SKETCH

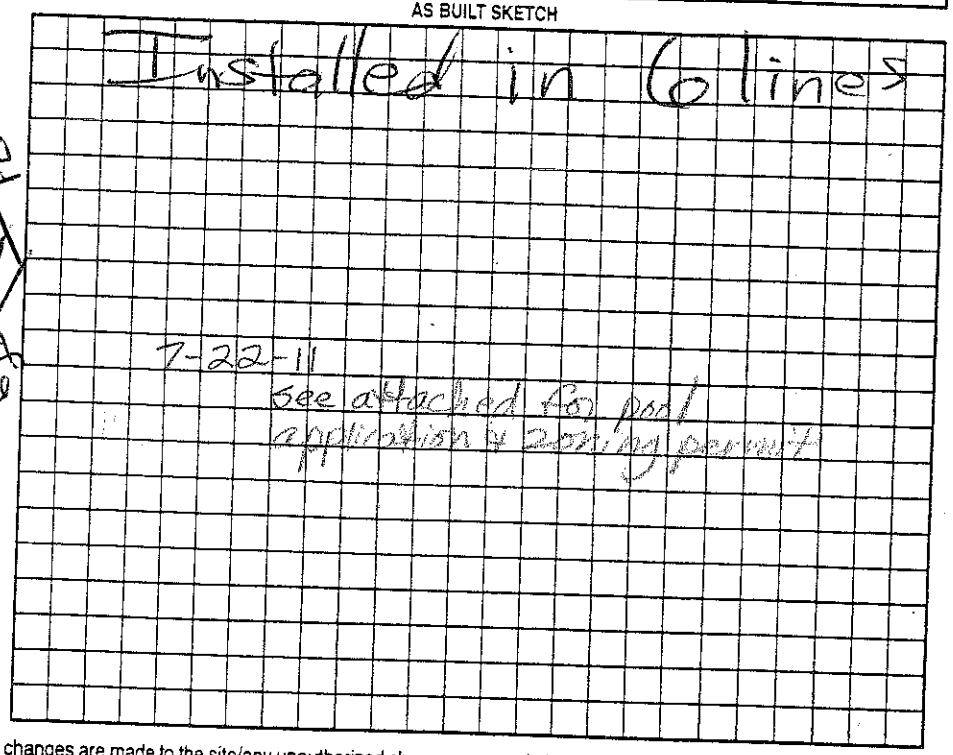

Permit can be suspended or revoked if any false information is supplied toward securing the permit/any unauthorized changes are made to the site/any unauthorized changes are made in the installation of the system. Improvement Permit with plat valid without expiration ☐ Improvement Permit with site plan valid for sixty months ☐ Authorization to Construct is valid for a period equal to that of Improvement Permit - not to exceed sixty months.

Signed: [signature]

Improvement Permit by: Maria H. Dotson RS date 5-10-07

Authorization to Construct by: Joseph E. Alt date 5-23-07

Installed by: C&E RS

Operation Permit by: Maria H. Dotson date 5/13/2010

Existing System Inspection by: date

HEALTH DEPT. COPY: WHITE OWNER COPY (FINAL): YELLOW OWNER COPY (INITIAL): PINK

IREDELL COUNTY HEALTH DEPARTMENT

#375

STATESVILLE 704-878-5305 MOORESVILLE 704-664-5281

IMPROVEMENT PERMIT / AUTHORIZATION TO CONSTRUCT / OPERATION PERMIT / EXISTING SYSTEM INSPECTION

PERMIT# 129580 PIN# 4730705378.041 DATE 1-11-07

OWNER OR APPLICANT BO of North Carolina Inc PHONE: Business 704 489-4663 Home

ADDRESS 5734 Highway 150 East Denver, NC 28037

LOCATION Derth Rd (North TL Winding Forest (just past Neil Farm Rd) TR Crooked Branch on left

SUBDIVISION Winding Forest BLOCK / SECTION LOT 41 LOT AREA .6 Acre SITE CLASS PS DESIGN FLOW 480 gpd T.A.R. .35

Septic Tank: 000 Gallons; STB Date

Pump Tank: 1000 Gallons; PT Date

Pump Make: Model Serial No.

Nitrification Field: No Fields 1 Square Feet 1185 Linear Feet 395

No Lines 7 Trench Width 36" Max Trench Bottom Depth 36" Gravel Depth N/A

☒ New System ☐ Repair ☐ Expansion System Type: I II III IV V VI

System Description: 4-Panel Blk

Repair System Description: PM - 25% Reduction

Maintenance Agreement Required: ☐ Yes ☐ No

☒ House/Mod. Home ☐ Mobile Home ☐ Business ☐ Other

No. Bedrooms 4 No. Persons No. Employees

Water Supply: ☐ Individual ☐ Public ☒ Community


☐ Gravity ☐ Pressure ☐ Slab ☐ Crawl Space ☐ Basement w/plumbing ☐ Basement wo/plumbing

Comments/Conditions: Better soil is in Front of house (.25 LTAR); Soils below house in repair area are Shallow & .2 LTAR


Comments/Conditions: Trench width per approved plan By Rollans Soil & Environmental

Use backfill to create slope/drain Away from House

Scale 1:50 INITIAL SITE SKETCH

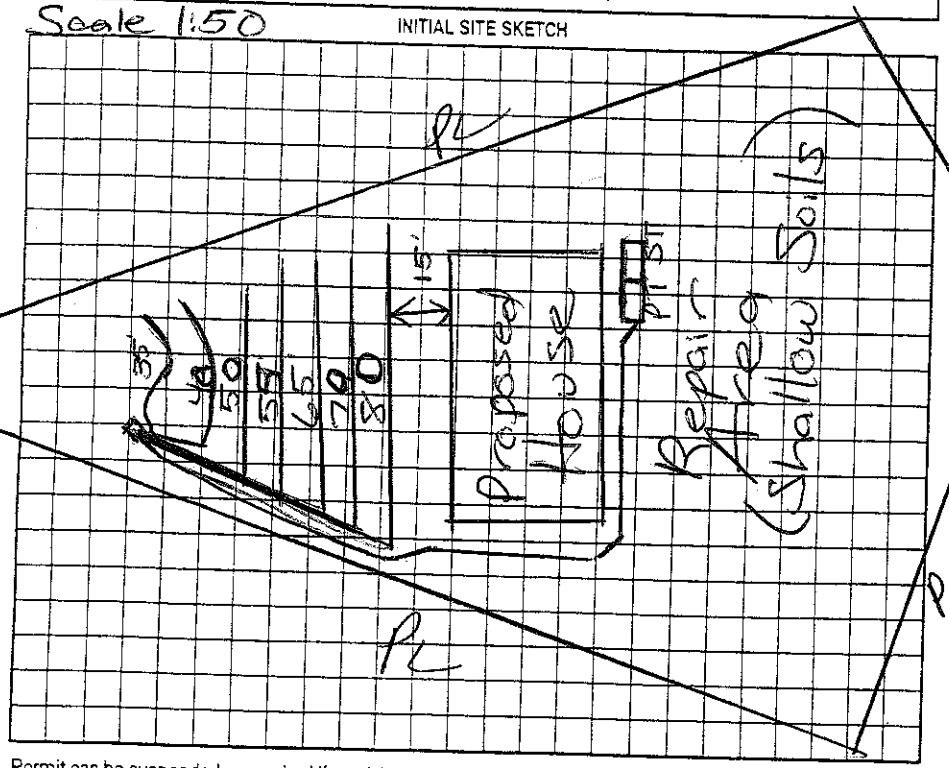

AS BUILT SKETCH

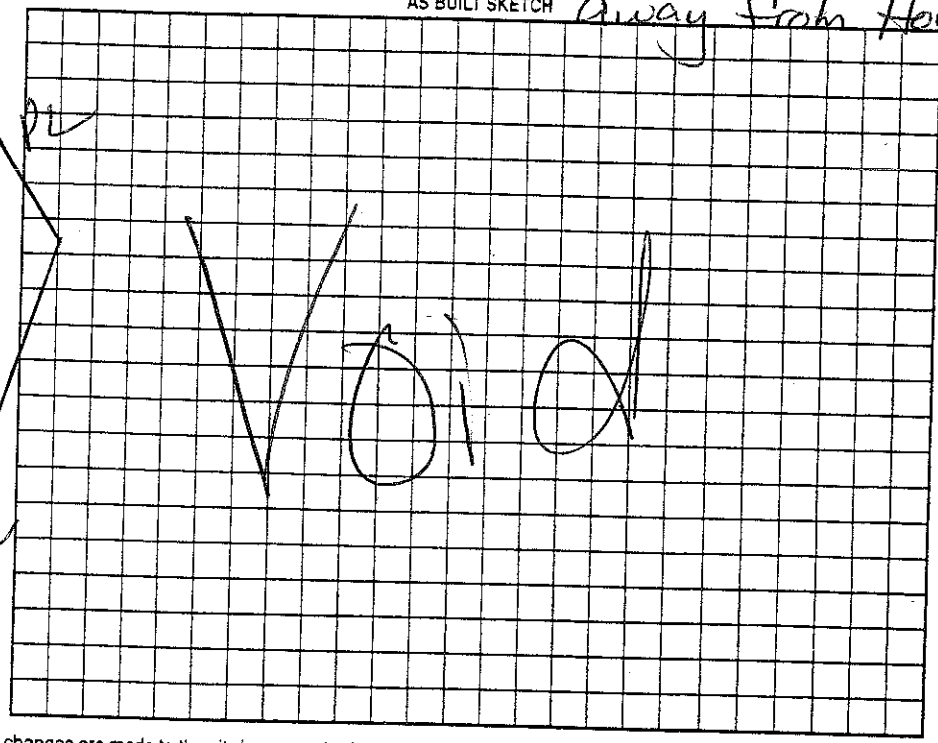

Permit can be suspended or revoked if any false information is supplied toward securing the permit/any unauthorized changes are made to the site/any unauthorized changes are made in the installation of the system. Improvement Permit with plat valid without expiration ☑ Improvement Permit with site plan valid for sixty months ☐ Authorization to Construct is valid for a period equal to that of Improvement Permit – not to exceed sixty months.

Signed: Diane Rollans date 1-23-07

Improvement Permit by: Maria H Dolan RS date 1/11/07

Authorization to Construct by: date

Installed by:

Operation Permit by: date

Existing System Inspection by: date

HEALTH DEPT. COPY: WHITE OWNER COPY (FINAL): YELLOW OWNER COPY (INITIAL): PINK