IREDELL COUNTY HEALTH DEPARTMENT

STATESVILLE 704-878-5305 MOORESVILLE 704-664-5281

IMPROVEMENT PERMIT / AUTHORIZATION TO CONSTRUCT / OPERATION PERMIT / EXISTING SYSTEM INSPECTION

PERMIT# 129578 PIN# 4730705378 4730-60-5676 DATE 6-19-07

OWNER OR APPLICANT Anaheim Homes PHONE: Business 907-9250 Home

ADDRESS P.O. Box 610 Cornelius NC 28031

LOCATION Perth Rd N. TL Winding Forest TR Crooked Branch on right

SUBDIVISION Winding Forest BLOCK / SECTION J LOT 43 LOT AREA .710 Acre SITE CLASS PS DESIGN FLOW 480gpd L.T.A.R. .3

Septic Tank: 1000 Gallons; STB 1012 Date 7-14-07
Pump Tank: Gallons; PT Date
Pump Make: Model Serial No.
Nitrification Field; No Fields 1 Square Feet 1600 Linear Feet 400
No Lines 4 Trench Width 36" Max Trench Bottom Depth 36"

☒ New System ☐ Repair ☐ Expansion System Type: I (II) III IV V VI
System Description: Gravity -25% Reduction
Repair System Description: LPP Panel Black
Maintenance Agreement Required: ☐ Yes ☐ No

☒ House/Mod. Home ☐ Mobile Home ☐ Business ☐ Other
No. Bedrooms 4 No. Persons No. Employees


Water Supply: ☐ Individual ☐ Public ☒ Community

Gravel Depth N/A ☒ Gravity ☐ Pressure ☐ Slab ☒ Crawl Space ☐ Basement w/plumbing ☐ Basement wo/plumbing


Comments/Conditions: Keep Septic System 10Ft from PL & 15 Ft from pool cut.

Comments/Conditions:

Scale 1:50 INITIAL SITE SKETCH

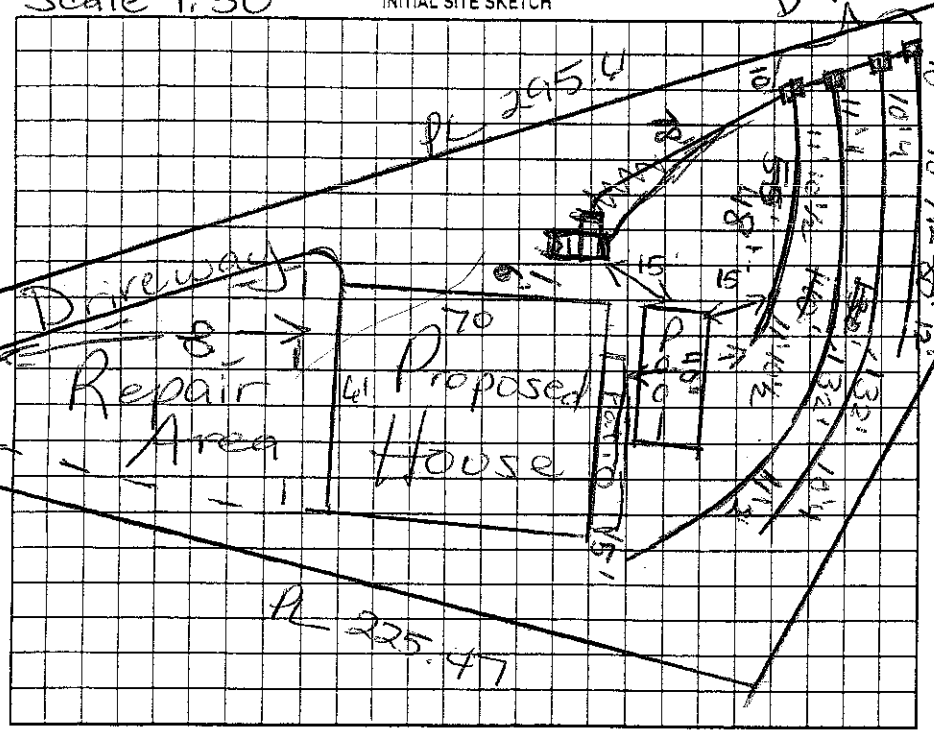

AS BUILT SKETCH

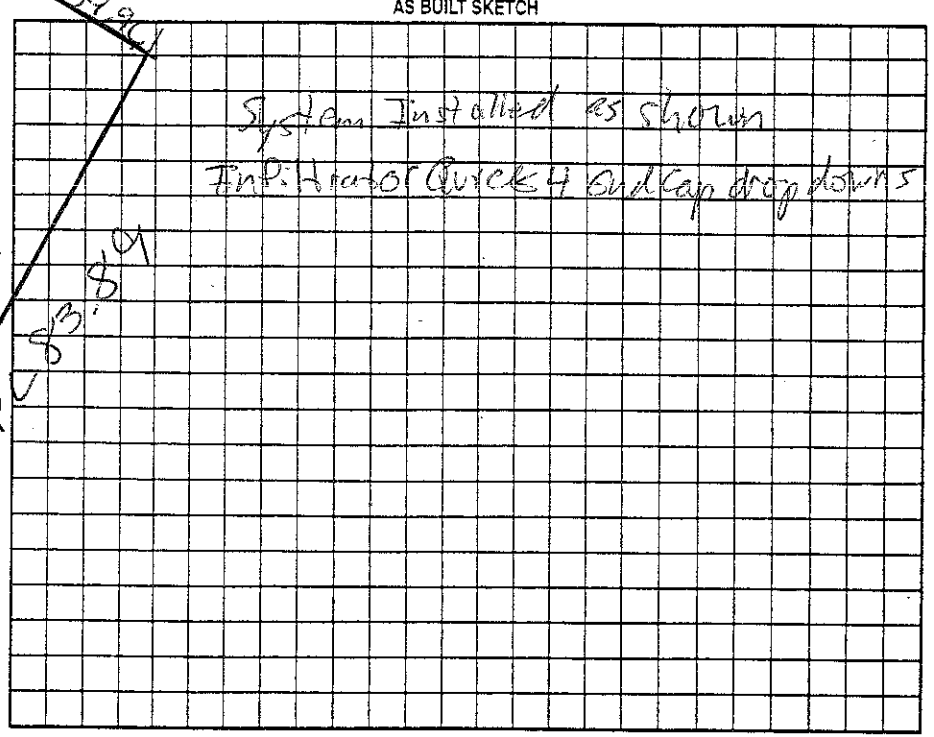

Permit can be suspended or revoked if any false information is supplied toward securing the permit/any unauthorized changes are made to the site/any unauthorized changes are made in the installation of the system. Improvement Permit with plat valid without expiration ☐ Improvement Permit with site plan valid for sixty months ☐ Authorization to Construct is valid for a period equal to that of Improvement Permit – not to exceed sixty months.

Signed: date 6/26/07 Installed by: Tommy Frye

Improvement Permit by: RS date 6/19/07 Operation Permit by: Anthony Cole II date 4/17/08

Authorization to Construct by: RS date 6/19/07 Existing System Inspection by: date

HEALTH DEPT. COPY: WHITE OWNER COPY (FINAL): YELLOW OWNER COPY (INITIAL): PINK