IREDELL COUNTY HEALTH DEPARTMENT

Statesville Office (704) 878-5305 Mooresville Office (704) 660-3625 PERMIT # 174961

IMPROVEMENT PERMIT / AUTHORIZATION TO CONSTRUCT / OPERATION PERMIT / EXISTING SYSTEM

PIN # 4730-60-6258

APPLICANT: ADRIAN POP APPLICANT ADDRESS: SANTA ANA, CA

SITE ADDRESS: 177 CROOKED BRANCH WAY TROUTMAN, NC PHONE: 980-429-1580 ~~ALT. PHONE:~~ RUSSELL WILLIAMS


SITE DIRECTIONS: PERTH, TL WINDING FORREST, TR CROOKED BRANCH, ONL

SUBDIVISION: WINDING FORREST SECTION: ___ LOT # 40 LOT AREA: .625 AC DESIGN FLOW: 480 L.T.A.R.: .3

Septic Tank	1000 (gal)	STB	160	Date	10-20-12	☒ New System ☐ Repair ☐ Expansion	System Type: I II (III) IV V VI	☒ Residence	No. Bedrooms	4	Water Supply
Pump Tank	(gal)	PT		Date		System Description:	25% REDUCTION	☐ Business	No. Persons		☐ Private
Pump Make		Model		Serial #		Repair System Description:	PANEL BLOCK	☐ Other	No. Employees		☐ Public
# Nitrification Fields	1	# Lines	4@100'	Linear Ft:	400'	Maintenance Agreement Required:	☐ YES ☒ NO	☐ Slab	☒ Crawl Space		☒ Community
Trench Width	36"	Max. Trench Bottom Depth	36"	Gravel Depth	—		☒ GRAVITY ☐ PRESSURE	☐ Basement w/plumbing			☐ Basement w/o plumbing

Comments / Conditions:

INITIAL SITE SKETCH

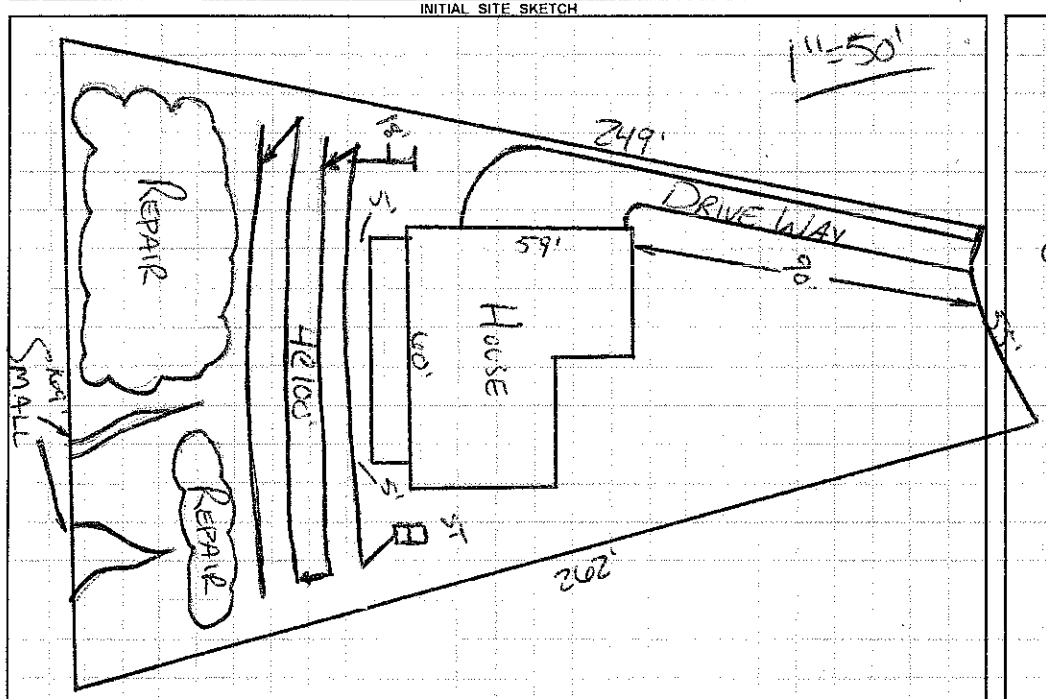

AS BUILT SKETCH

ARC 36 INSTALLED
SYSTEM INSTALLED AS SHOWN

CROOKED BRANCH WAY

Permit can be suspended or revoked if any false information is supplied toward securing the permit / any unauthorized changes are made to the site / any unauthorized changes are made in the installation of the system. **CONTACT A LOCATOR SERVICE PRIOR TO ANY EXCAVATION**

☐ **IMPROVEMENT PERMIT** *with plat valid without expiration.* ☒ **IMPROVEMENT PERMIT** *with site plan valid for 60 mos.* ☒ **AUTHORIZATION TO CONSTRUCT** *valid for period equal to IMPROVEMENT PERMIT--not to exceed 60 mo.*

Owner / Applicant Signature: Date: 2-12-2013 Installed by: NEIL YODER

IMPROVEMENT PERMIT by: Date: 2-4-13 OPERATION PERMIT by: Date: 3-28-13

AUTHORIZATION TO CONSTRUCT by: Date: 2-4-13 Existing System Inspected by: Date:

Health Dept. Copy - WHITE Applicant (Final Approval) - YELLOW Applicant (Conditional Approval) - PINK