IREDELL COUNTY HEALTH DEPARTMENT

STATESVILLE 704-878-5305 MOORESVILLE 704-664-5281

4730608896

IMPROVEMENT PERMIT / CERTIFICATE OF COMPLETION / OPERATION PERMIT / EXISTING SYSTEM INSPECTION

PROPERTY DESCRIPTION NO. 17432 DATE Nov. 18, '93 TAX MAP NO. 3F2A 37 Watershed: ☑ Yes ☐ No

OWNER OR CONTRACTOR Wayne Folger PHONE: Business _____ Home 528-3474 L.N.

ADDRESS Rt 1 Box 394 B, Troutman

LOCATION Peeler Rd. N. to Shady Cove (1403) on left ~3/4 mile

SUBDIVISION Shady Cove BLOCK / SECTION _____ LOT 37 LOT AREA 106' x ~255' SITE CLASS. P5 per 1996 DESIGN FLOW 360 gpd L.T.A.R. .25 - .3

Septic Tank: 1000 Gallons; STB 794 Date 9/26/96

Pump Tank: _____ Gallons; PT _____ Date _____

Pump Make: _____ Model _____ Serial No. _____

Nitrification Field: No Fields 2 Square Feet _____ Linear Feet ~240

No Lines 6 Trench Width 24" Max Trench Bottom Depth 28" Gravel Depth NA

☑ New System ☐ Repair System Type: I, II, III, IV, V, VI

System Description: gravity PPBPS

Repair System Description: same

Maintenance Agreement Required: ☐ Yes ☑ No

☑ House/Mod. Home No. Bedrooms 3

☐ Mobile Home No. Bathrooms 2½

☐ Business No. Employees _____

☐ Other _____


☐ Slab ☐ Crawl Space ☑ Basement w/plumbing ☐ Basement wo/plumbing

Water Supply: ☑ Individual ☐ Community ☐ Public

Comments: Follow contour. PPBPS laterals must be shallow. Exit plumbing from house accordingly. Install same footage total off each subfield.

Comments: Installed as shown on both sketch.

INITIAL SITE SKETCH

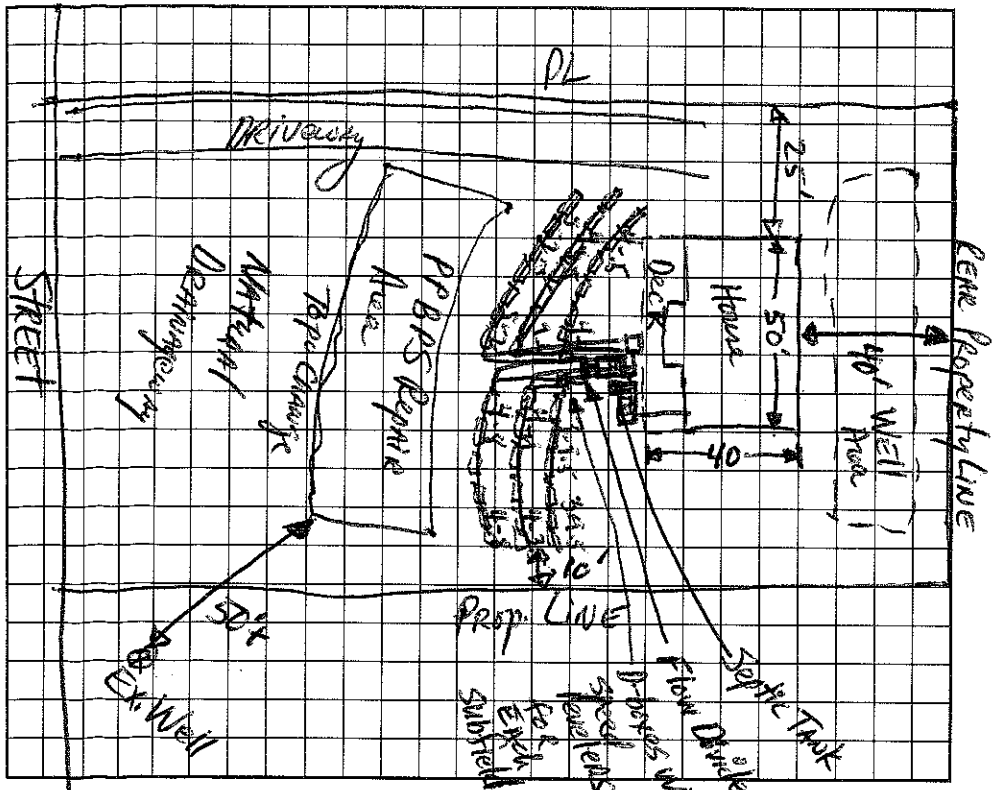

AS BUILT SKETCH

I understand that this permit can be suspended or revoked if any false information is supplied toward securing the permit/any unauthorized changes are made to the site/any unauthorized changes are made in the installation of the system. Improvement Permit is valid for 60 months from date of issuance.

Signed: Wayne Folger

Improvement Permit by: Mark D. Thomas IRS date 11/18/93

Existing System Inspection by: _____ date _____

Installed by: F J Ennis

Certificate of Completion by: _____ date _____

Operation Permit by: Wesley Sparkman RS date 11/7/96

HEALTH DEPT. COPY: WHITE INSPECTION COPY (FINAL): GREEN OWNER COPY (FINAL): YELLOW INSPECTION COPY (INITIAL): PINK OWNER COPY (INITIAL): GOLD