# IREDELL COUNTY HEALTH DEPARTMENT

STATESVILLE 704-878-5305 325.00 Paid MOORESVILLE 704-664-5281

## IMPROVEMENT PERMIT / AUTHORIZATION TO CONSTRUCT / OPERATION PERMIT / EXISTING SYSTEM INSPECTION

PERMIT# 102547 PIN# 4730 61 5127 DATE 10/3/01

OWNER OR CONTRACTOR David Story PHONE: Business 336-768-2300 Home

ADDRESS 4355 Winterberry Ridge Ct. Winston Salem, NC. 27103

LOCATION 150 W TR Perth Rd TL Shady Cove Ln. on (R) before end of road.

SUBDIVISION Shady Cove BLOCK / SECTION LOT 28 LOT AREA .57 SITE CLASS. PS DESIGN FLOW 360 L.T.A.R. .3

Septic Tank: 1000 Gallons; STB 794 Date 6/03/03

Pump Tank: 1000 Gallons; PT 27 Date 5/28/03

Pump Make: Model Serial No.

Nitrification Field: No Fields 1 Square Feet 420 Linear Feet 210

No Lines 3 @ 70' Trench Width 2-3' Max Trench Bottom Depth 3'

☑ New System ☐ Repair System Type: I, II, III, IV, V, VI

System Description: LP - 16" PPBPS

Repair System Description: SAME

Maintenance Agreement Required: ☒ Yes ☐ No

Gravel Depth SAND

☒ House/Mod. Home No. Bedrooms 3

☐ Mobile Home No. Bathrooms 3

☐ Business No. Employees

☐ Other

☐ Slab ☐ Crawl Space ☒ Basement w/plumbing ☐ Basement wo/plumbing


Water Supply: ☒ Individual ☐ Public ☐ Community

EXISTING


Comments:/Conditions:

Comments:/Conditions:

INITIAL SITE SKETCH

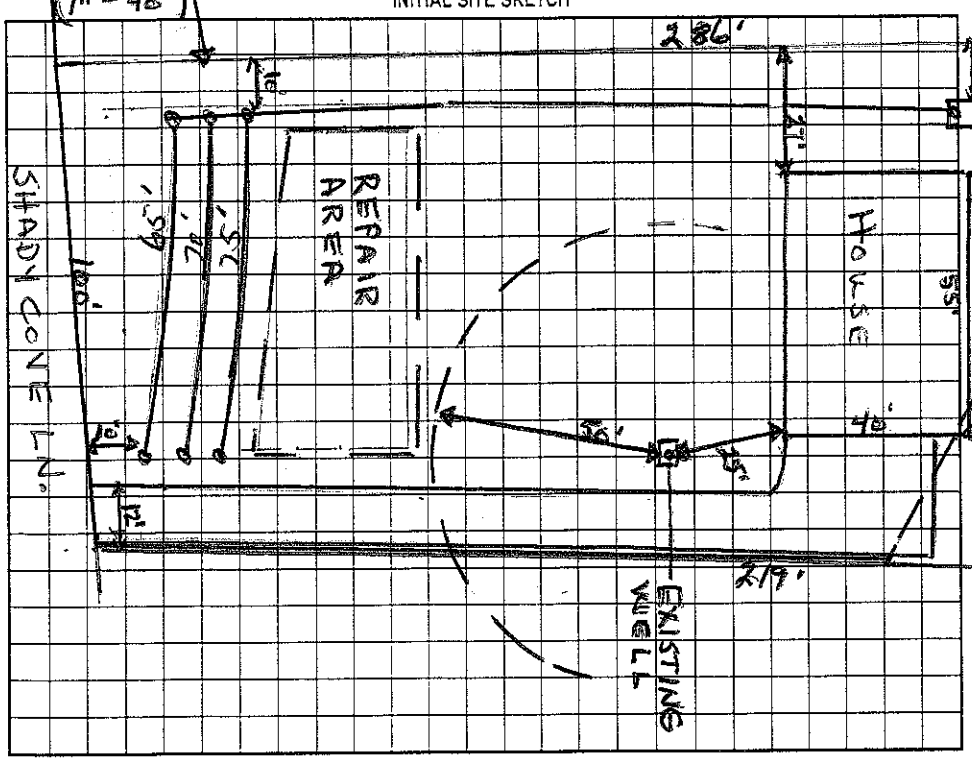


AS BUILT SKETCH

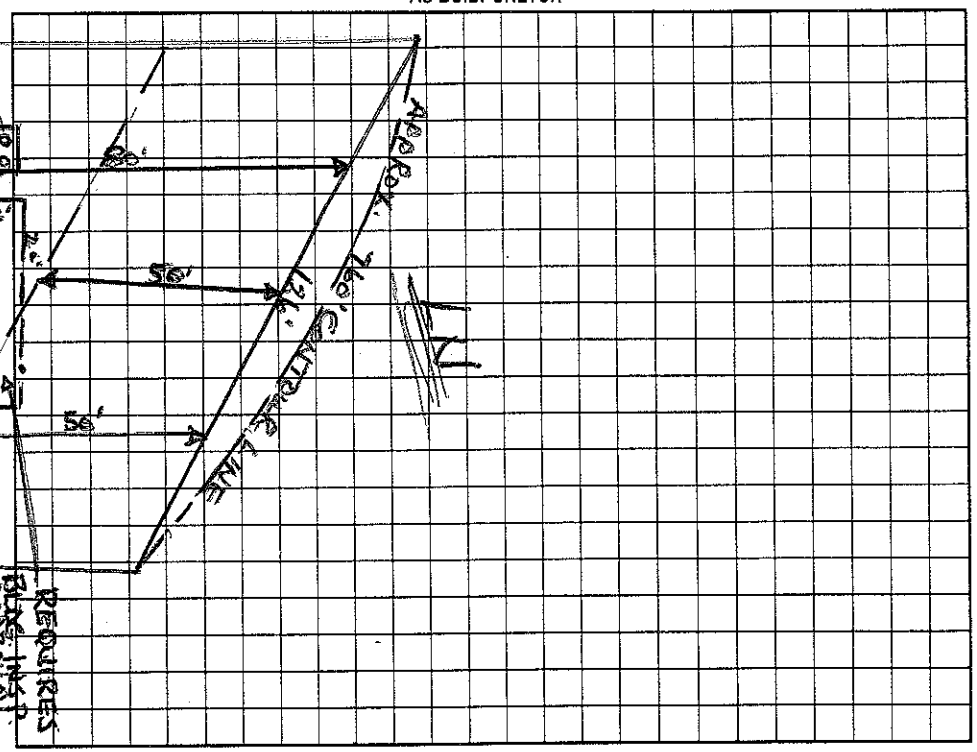


Permit can be suspended or revoked if any false information is supplied toward securing the permit/any unauthorized changes are made to the site/any unauthorized changes are made in the installation of the system. Improvement Permit with plat valid without expiration. Improvement Permit with site plan valid for sixty months. Authorization to Construct is valid for a period equal to that of Improvement Permit – not to exceed sixty months.

Signed: David Story date 10/5/01

Improvement Permit by: Wesley Sparks R.S. date 10/3/01

Authorization to Construct by: Wesley Sparks RS date 10/3/01

Installed by: ABE-nothy

Operation Permit by: RS date 9/26/03

Existing System Inspection by: date

HEALTH DEPT. COPY: WHITE OWNER COPY (FINAL): YELLOW OWNER COPY (INITIAL): PINK