4730-61-7141

IREDELL COUNTY HEALTH DEPARTMENT

STATESVILLE 704-878-5305 MOORESVILLE 704-664-5281

IMPROVEMENT PERMIT / CERTIFICATE OF COMPLETION / OPERATION PERMIT / EXISTING SYSTEM INSPECTION

PROPERTY DESCRIPTION NO. 19974 DATE 2/17/95 TAX MAP NO. ~~3F 2 A 26~~ Watershed: ☑ Yes ☐ No

OWNER OR CONTRACTOR Don Lunsford PHONE: Business _____ Home 663-6213

ADDRESS 2195 Perth Rd. / Mooresville, NC. 28115

LOCATION Perth N TL on Shady Cove ~ .4 mile on (R) beside next to Amenity lot.

SUBDIVISION Shady Cove BLOCK / SECTION _____ LOT 26 LOT AREA .38 Ac SITE CLASS. P DESIGN FLOW 360 L.T.A.R. .35

Septic Tank: 1000 Gallons; STB 794 Date 3/6/96

Pump Tank: 1000 Gallons; PT 27 Date 6/2/96

Pump Make: Goulds Model VE0511H Serial No. A9625660

Nitrification Field: No Fields 1 Square Feet 1028 Linear Feet *180

No Lines 3 Trench Width 24" Max Trench Bottom Depth 30"

☑ New System ☐ Repair System Type: I, II, III, (IV) V, VI

System Description: PRES - PANEL

Repair System Description: SAME < 83 PLAT

Maintenance Agreement Required: ☑ Yes ☐ No

Gravel Depth 6" SAND

☑ House/Mod. Home No. Bedrooms 3

☐ Mobile Home No. Bathrooms 2.5

☐ Business No. Employees ____

☐ Other _____


☐ Slab ☑ Crawl Space ☐ Basement w/plumbing ☐ Basement wo/plumbing

Water Supply:
☑ Individual
☐ Community
☐ Public

Comments: * 16" PRESSURE DOSED PANEL TYPE 4 SYSTEM
TIGHT - < 83 PLAT ALLOWS MIN REPAIR AREA
41 PANELS 100 GAL/DOSE 2' PRES HEAD
ALARM W/ FLOAT REQ.


Comments:

INITIAL SITE SKETCH

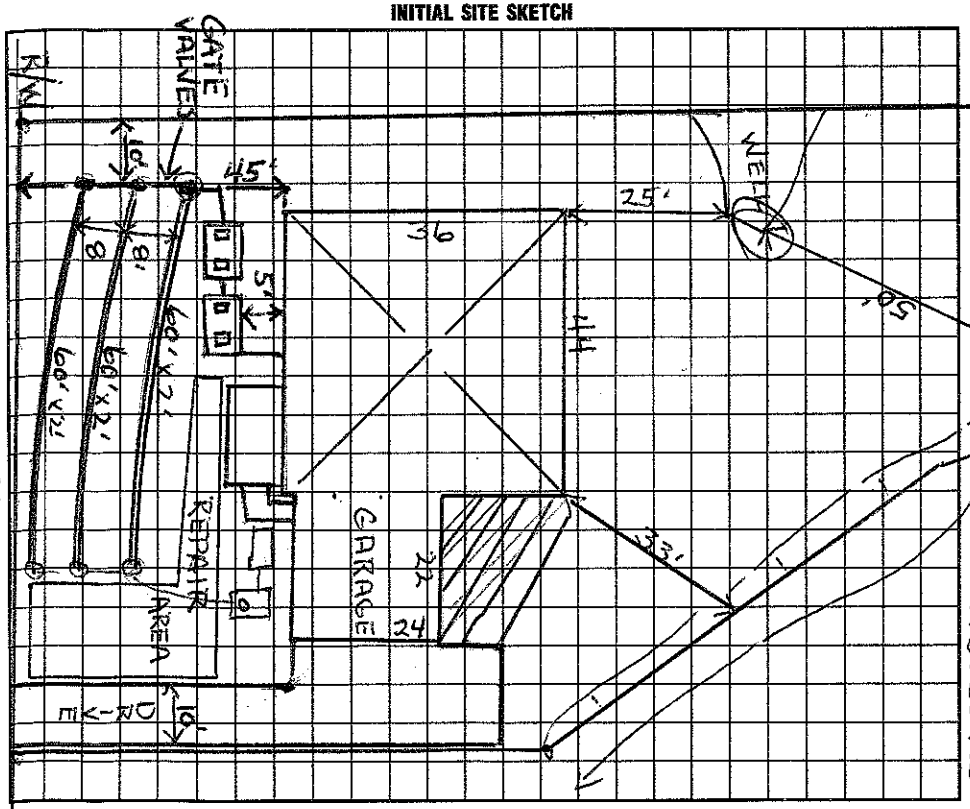

SHADY COVE RD.

AS BUILT SKETCH

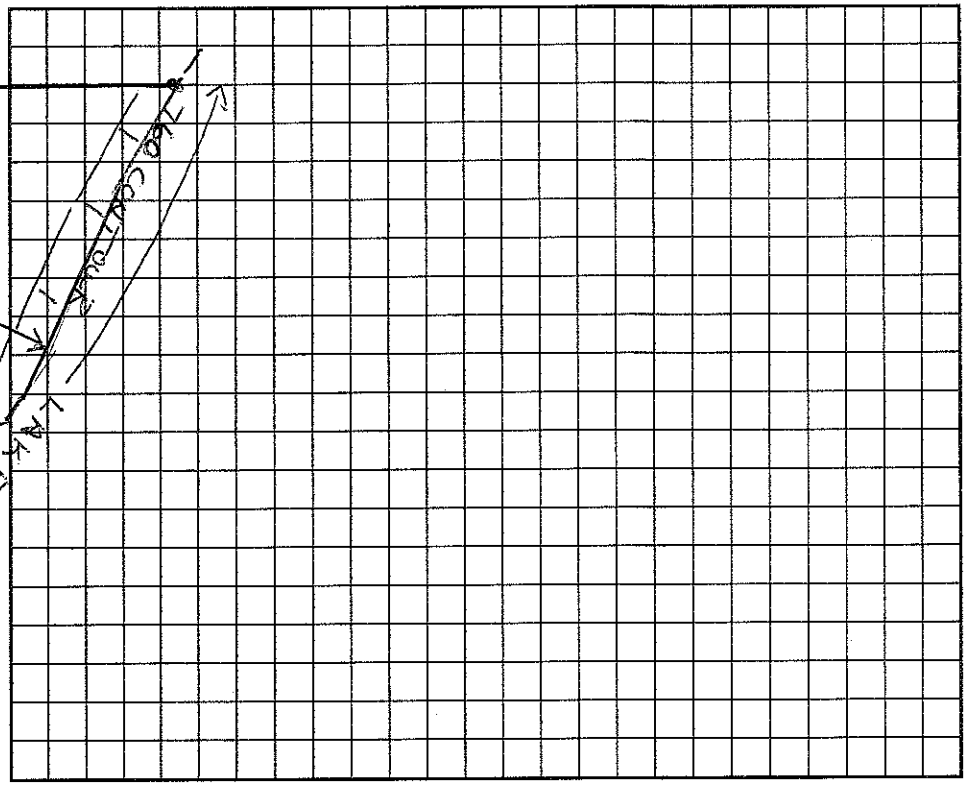

I understand that this permit can be suspended or revoked if any false information is supplied toward securing the permit/any unauthorized changes are made to the site/any unauthorized changes are made in the installation of the system. Improvement Permit is valid for 60 months from date of issuance.

Signed: Donald E. Lunsford 2/20/95

Improvement Permit by: Wesley Sparks RS. date 2/17/94

Existing System Inspection by: _____ date _____

Installed by: F.T. Erwin

Certificate of Completion by: _____ date _____

Operation Permit by: Wesley Sparks R.S. date 7/29/96

HEALTH DEPT. COPY: WHITE INSPECTION COPY (FINAL): GREEN OWNER COPY (FINAL): YELLOW INSPECTION COPY (INITIAL): PINK OWNER COPY (INITIAL): GOLD