IREDELL COUNTY HEALTH DEPARTMENT

Statesville Office – Central Permitting (704) 878-5305 Mooresville Office (704) 660-3625


PRIVATE DRINKING WATER WELL PERMIT # 20259 **PIN #** 4730626368 **Type of Permit (circle one):** New Repair Abandonment

APPLICANT NAME: Michael Nelson ADDRESS: 328 River Birch Circle PHONE: 704-201-5930

DIRECTIONS TO SITE: Hwy 215 TR Perth Rd TR Driftwood Cove Dr.

SITE ADDRESS: 157 Driftwood Cove Dr. SUBDIVISION: N/A SECTION/LOT: N/A

Initial Site Sketch

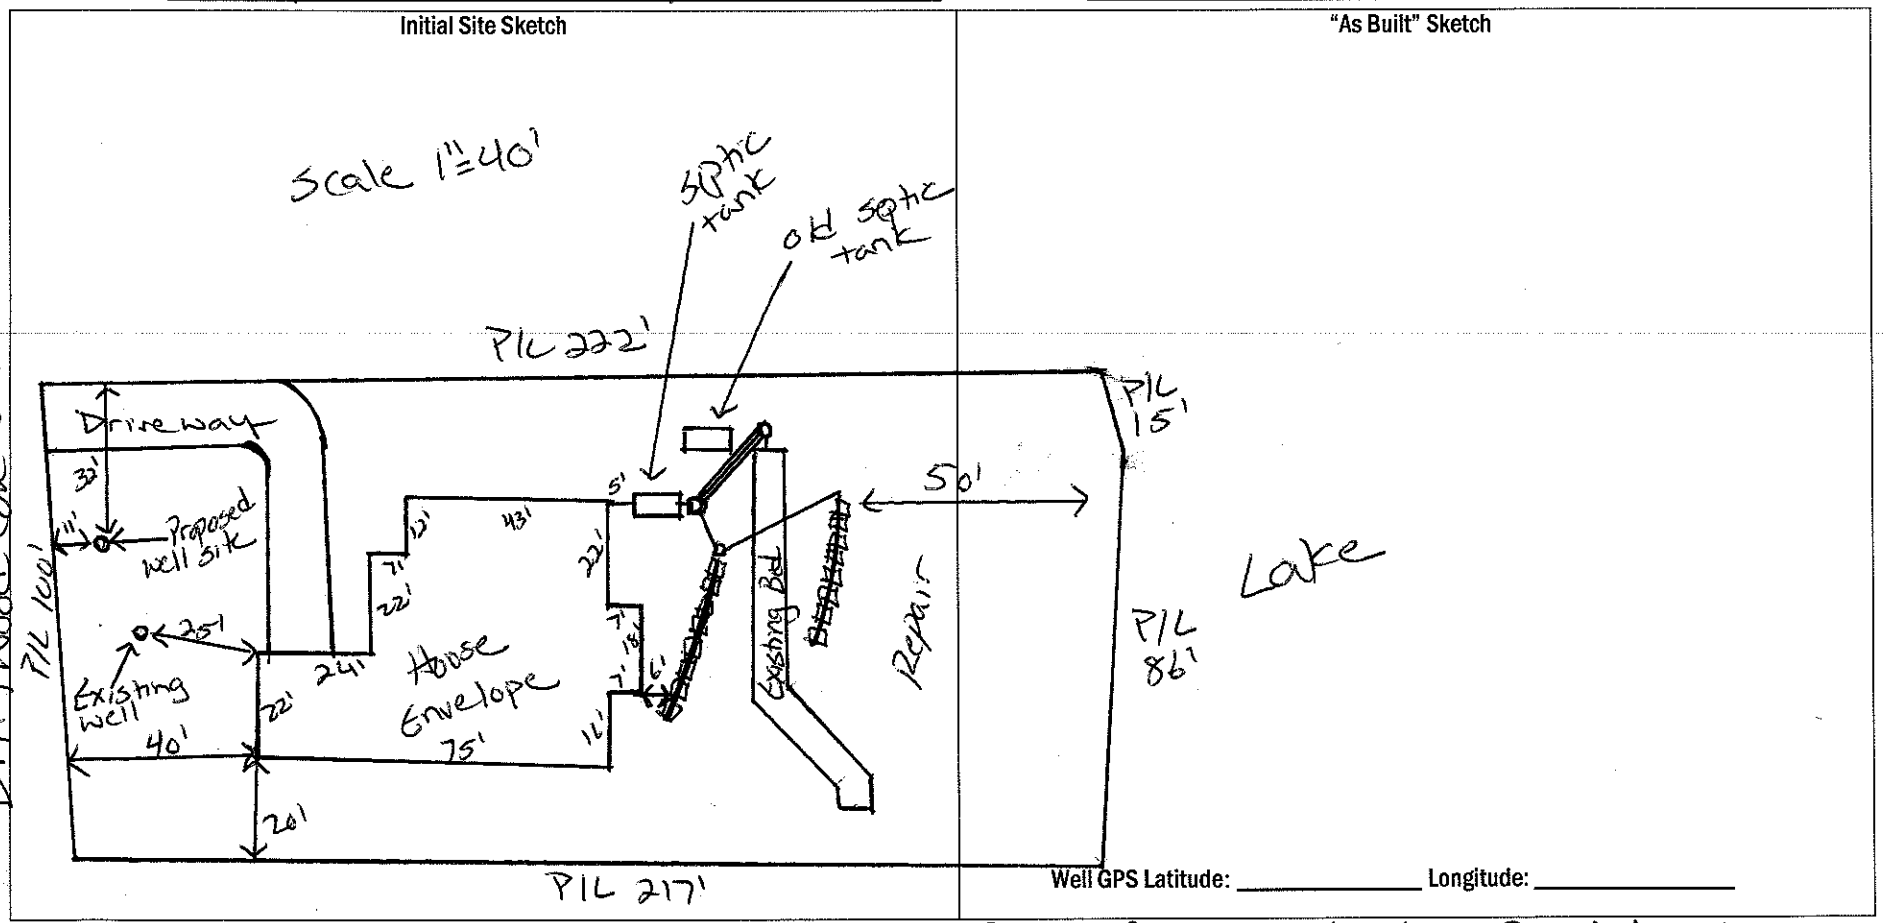

"As Built" Sketch

Well GPS Latitude: _____ Longitude: _____

PERMIT CONDITIONS/COMMENTS: Well site is a minimum of 25' from any building foundations. Well site is a minimum of 100' away from septic system.

WELL PERMIT ISSUED BY: Justin Henderson DATE: 6-3-14 (Permit is valid for 5 years from date issued. This permit may be revoked if it is determined there has been a material change in any fact or circumstance upon which the permit is issued. Actions of the employees of the Iredell County Health Department shall in no way be taken as a guarantee that this well will produce water of any particular quantity or quality or for any amount of time. Employees of the Iredell County Health Department assume no liability for any damages, either direct or consequential which may be caused by this well.)

Well Contractor: Advanced Well Drilling CONTRACTOR CERT #: 3252 GROUT INSPECTION BY: Justin Henderson DATE: 7-30-15

OR CERTIFICATION OF GROUT NOT WITNESSED BY DEPT: _____ DATE: _____ WELL HEAD INSPECTION BY: Justin Henderson DATE: 9-2-15

WELL HEAD INSPECTION (check when completed): GROUT TO GROUND SURFACE ☑ WELL CONTRACTOR ID PLATE ☑ PUMP INSTALLER ID PLATE ☑ SAMPLE PORT ☑

ACCESS PORT / VENT ☑ WELL SEAL ☑ WELL HEAD 12 INCHES / PITLESS ADAPTOR 8 INCHES ABOVE GRADE ☑

CERTIFICATE OF COMPLETION BY: Justin Henderson DATE: 9-2-15 WATER SAMPLES BY: Justin Henderson DATE: 11-17-15

Attachments: Form GW-1a (required except for abandonment) ☑ Form GW-30 ☐ Water Sample Results ☑ Plat ☐

Health Dept. Copy – White Applicant Certificate of Completion – Yellow Applicant Well Construction Permit - Pink