THIS PERMIT VOIDS PERMIT ISSUED 7-29-11

IREDELL COUNTY HEALTH DEPARTMENT - *ENVIRONMENTAL HEALTH* ☒ STATESVILLE OFFICE 704-878-5305 ☐ MOORESVILLE OFFICE 704-664-5281

IMPROVEMENT PERMIT / AUTHORIZATION TO CONSTRUCT / OPERATION PERMIT / EXISTING SYSTEM INSPECTION

PERMIT # 170296 PIN # 4730 62 8540 DATE 2-7-12

OWNER Raymond May APPLICANT: PHONE: Home/Cell # 704-634-1171 Business #

SITE ADDRESS 1417 Driftwood Cove OWNER / APPLICANT ADDRESS 2388 Capes Cove Dr.

SITE DIRECTIONS Perth Rd (S), (R) on Driftwood, House on (L)

SUBDIVISION n/a BLOCK / SECTION n/a LOT # LOT AREA .561 DESIGN FLOW 240 L.T.A.R. .3

Septic Tank 1000 Gallons: STB 2071-1060 Date n/a

Pump Tank 1000 Gallons: P.T 2077-1060 Date n/a

Pump Make Model WE-E5121HH0 Serial # 1720875

No. Nitrification Fields: 1 No. Lines 1 Linear Feet 200

Trench Width 36" Max. Trench Bottom Depth 30" Gravel Depth n/a

☒ New System ☐ Repair ☐ Expansion System Type I II III IV V VI

System Description: 25% Reduction - Pump

Repair System Description: 50% Reduction - Pump

Maintenance Agreement Required ☐ YES ☒ NO

☐ GRAVITY ☒ PRESSURE

☒ Residence No. Bedrooms 2

☐ Business No. Persons

☐ Other No. Employees

☒ Slab ☒ Crawl Space


☐ Basement w/plumbing ☐ Basement w/o plumbing

Water Supply: ☒ Private ☐ Public ☐ Community

Comments / Conditions

* Abandon well, and new well shall be constructed according to new permit.

INITIAL SITE SKETCH

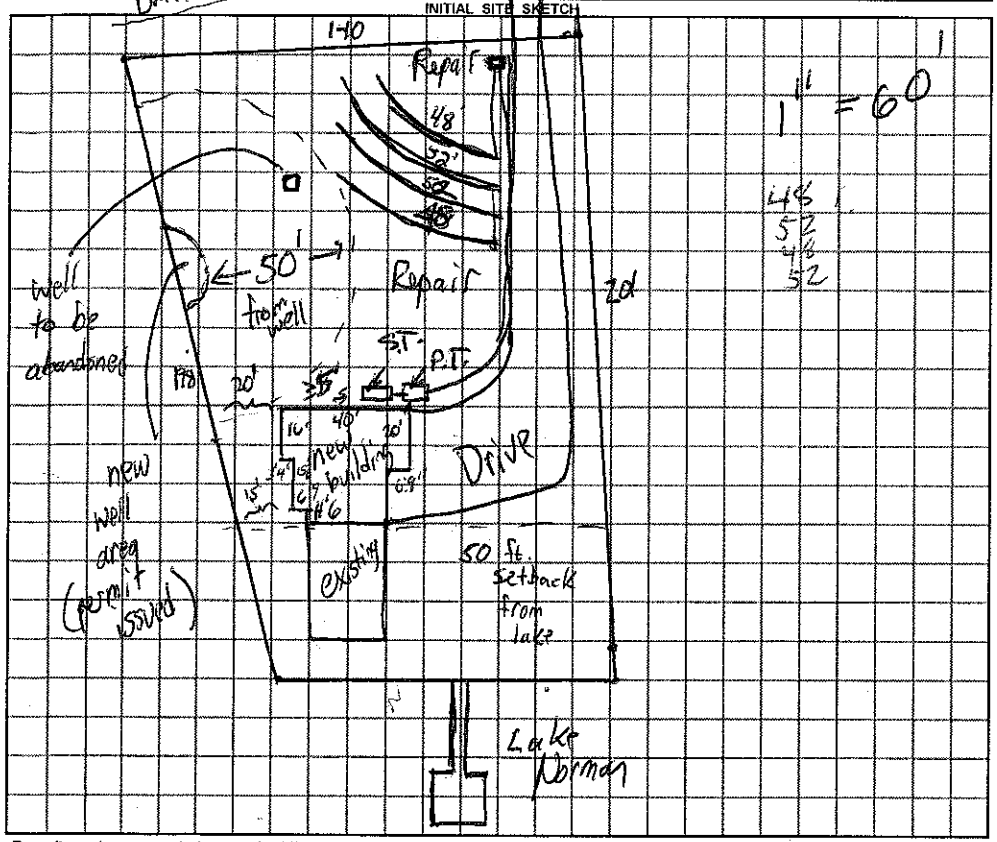

AS BUILT SKETCH

Permit can be suspended or revoked if any false information is supplied toward securing the permit / any unauthorized changes are made to the site / any unauthorized changes are made in the installation of the system.

☐ ***IMPROVEMENT PERMIT*** *with plat valid without expiration.* ☒ ***IMPROVEMENT PERMIT*** *with plat valid without expiration. site plan valid 60 mo.* ☒ ***AUTHORIZATION TO CONSTRUCT*** valid for period equal to IMPROVEMENT PERMIT--not to exceed 60 mo.

Owner / Applicant Signature: Raymond May Raymond May Date 2-7-12 / 2-10-12 Installed by: Steve Jordan

IMPROVEMENT PERMIT by: REHS Date 2-7-12 OPERATION PERMIT by: REHS Date 10-22-12

AUTHORIZATION TO CONSTRUCT by: REHS Date 2-10-12 Existing System Inspected by: REHS Date

YOU SHOULD CONTACT A LOCATOR SERVICE PRIOR TO ANY EXCAVATION

White Copy – Environmental Health YELLOW COPY (Final) Owner / Applicant PINK COPY (Initial) Owner / Applicant