9:30

IREDELL COUNTY HEALTH DEPARTMENT

STATESVILLE 704-878-5305 MOORESVILLE 704-664-5281

IMPROVEMENT PERMIT / CERTIFICATE OF COMPLETION / OPERATION PERMIT / EXISTING SYSTEM INSPECTION

PROPERTY DESCRIPTION NO. 18364 DATE 8-17-94 TAX MAP NO. 3F-8-A-11 Watershed: ☐ Yes ☑ No

OWNER OR CONTRACTOR Clyde Hall Enter, Inc. PHONE: Business 855-1962 Home

ADDRESS P.O. Box 2107 Salisbury, N.C. 28145-2107

LOCATION From Troutman take Perth Rd. TR Perthwood Dr 3rd lot on L.

SUBDIVISION Perthwood 3ID BLOCK / SECTION LOT 12 LOT AREA 1.6 acres SITE CLASS. P.S. DESIGN FLOW 360 L.T.A.R. .35 gpd/ft²

Septic Tank: 1000 Gallons; STB 825 Date 1-17-97

Pump Tank: — Gallons; PT — Date —

Pump Make: — Model — Serial No.

Nitrification Field: No Fields 1 Square Feet 1035 Linear Feet 345'

No Lines 3 Trench Width 36" Max Trench Bottom Depth 24"

☑ New System ☐ Repair System Type: I, II, III, IV, V, VI

System Description: Conventional, gravity fed

Repair System Description: " "

Maintenance Agreement Required: ☐ Yes ☑ No

Gravel Depth 12"

☑ House/Mod. Home ☐ Mobile Home ☐ Business ☐ Other

No. Bedrooms 3 No. Bathrooms 2 No. Employees


☑ Slab ☐ Crawl Space ☐ Basement w/plumbing ☐ Basement wo/plumbing

Water Supply: ☑ Individual ☐ Community ☐ Public

Comments: INSTALL SYSTEM SHALLOW (no deeper than 24" to trench bottom) Keep lines and trenches on contour. Keep system min. 5' from foundation of home, 10' from all property lines, and 100' from any well. 100% Repair Area behind system, conventional, gravity fed.

Comments:

INITIAL SITE SKETCH

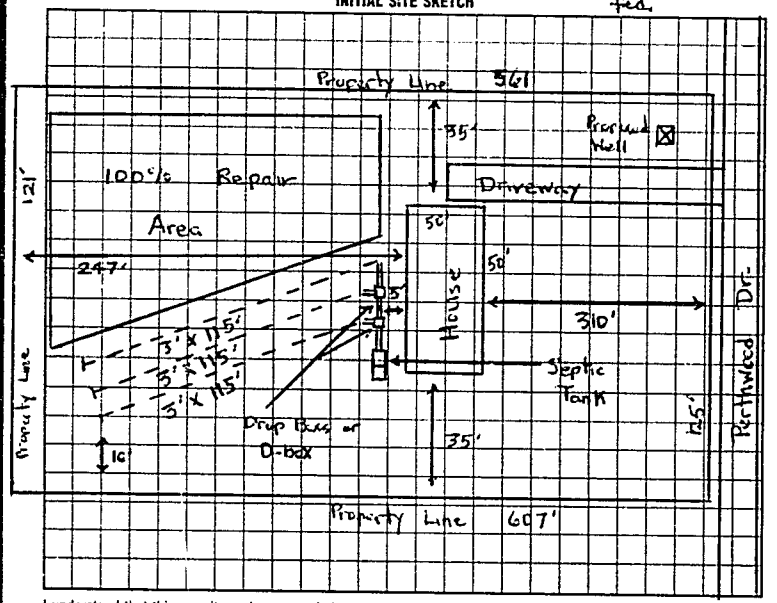

AS BUILT SKETCH

Same as initial sketch

I understand that this permit can be suspended or revoked if any false information is supplied toward securing the permit/any unauthorized changes are made to the site/any unauthorized changes are made in the installation of the system. Improvement Permit is valid for 60 months from date of issuance.

Signed:

Improvement Permit by: Michael J. Dennis / J.C. Moore date 8-17-94

Existing System Inspection by: date

Installed by: Wayne Clontz

Certificate of Completion by: date

Operation Permit by: J. C. moore date 3-25-97

HEALTH DEPT. COPY: WHITE INSPECTION COPY (FINAL): GREEN OWNER COPY (FINAL): YELLOW INSPECTION COPY (INITIAL): PINK OWNER COPY (INITIAL): GOLD

8060000