JAN. 1, 1989 0:11

IREDELL COUNTY HEALTH DEPARTMENT

STATESVILLE 704-878-5305 MOORESVILLE 704-664-5281

IMPROVEMENT PERMIT / CERTIFICATE OF COMPLETION / OPERATION PERMIT / EXISTING SYSTEM INSPECTIO

PROPERTY DESCRIPTION NO 1836200-3417 DATE 5-17-94 TAX MAP NO 3E-5-A-10 Watershed ☐ Yes ☐

OWNER OR CONTRACTOR Clyde Hall Enter., Inc. PHONE Business 855-1962 Home

ADDRESS P.O. Box 2107 Salisbury, N.C. 28145, 2107

LOCATION Exit Troutman take Perth Rd TR Pertwood Dr 1st Lot on L

SUBDIVISION Pertwood S/D BLOCK / SECTION NA LOT 10 LOT AREA 1.5 acres SITE CLASS P.S. DESIGN FLOW 360 L.T.A.R. .25 gpd/ft²

Septic Tank 1000 Gallons STB 1000 Date 5-24-94 ☑ New System Repair System Type I II III IV V ☑ House/Mod. Home No. Bedrooms 3

Pump Tank — Gallons PT — Date — System Description conventional gravity fed Mobile Home No. Bathrooms 2

Pump Make — Model — Repair System Description Pump to conventional Business No. Employees

Name on Septic Tank No Pump Square Feet 1620 Maintenance Agreement Required Yes ☑ No Other


No Lines 6 Trench Width 36" Bottom Depth 24" Gravel Depth 12" ☑ Slab Crawl Space Basement w plumbing Basement wo/plumbing

Water Supply ☑ Individual ☐ Community ☐ Public


Comments INSTALL SYSTEM SHALLOW (no deeper than 24" to stream bottom) Keep lines and trenches on contour. Keep system 5' from foundation of home, 10' from all property lines, and 5' from well. Install all trench, route surface waters around septic system

Comments

INITIAL SITE SKETCH 100% Repair At Front of lot, pump to conventional.

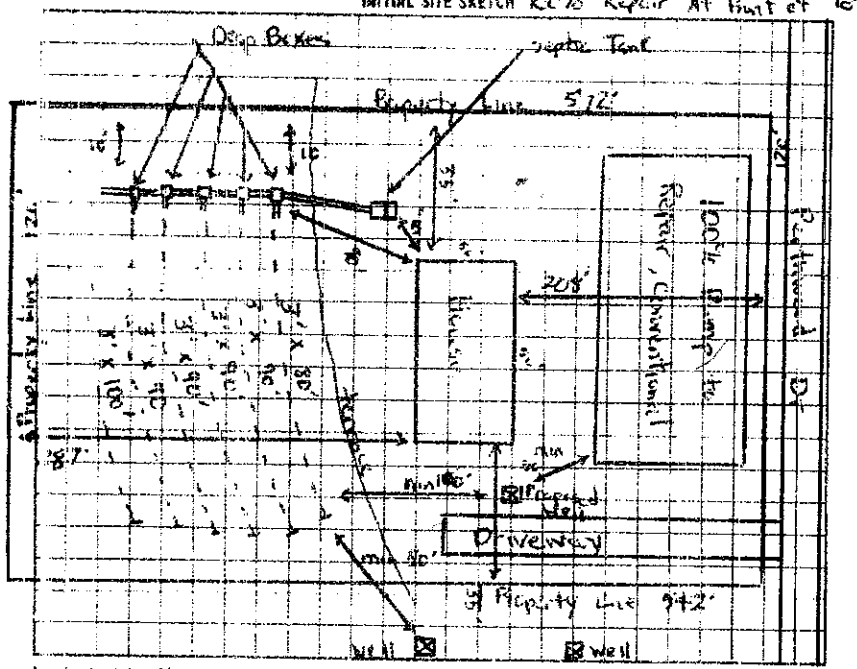

AS BUILT SKETCH

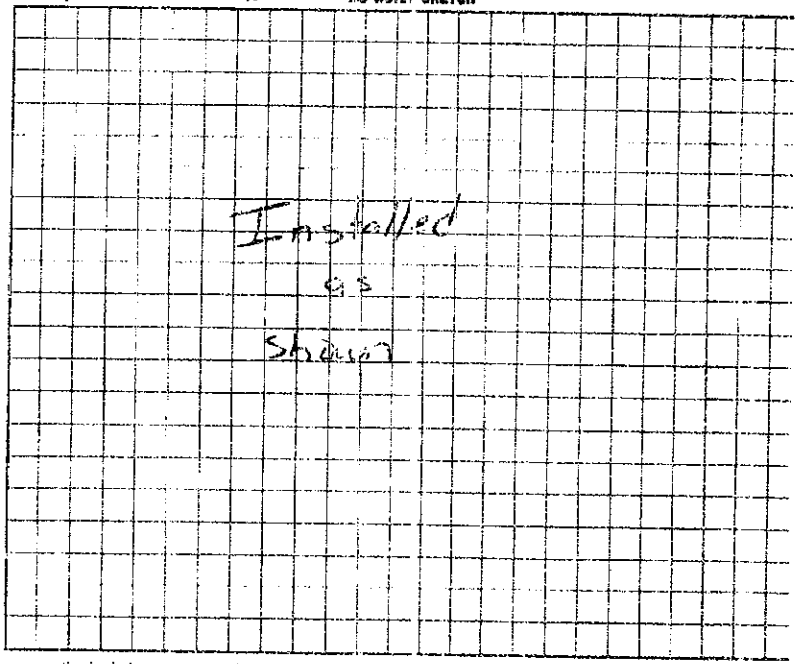

I understand that this permit can be suspended or revoked if any false information is supplied toward securing the permit/any unauthorized changes are made to the site/any unauthorized changes are made in the installation of the system Improvement Permit is valid for 60 months from date of issuance

Signature

Improvement Permit by [signature] / J.C. Mace date 5-17-94

Existing System Inspection by date

Installed by Wayne Clontz

Certificate of Completion by date

Operation Permit by [signature] date 6-6-94

WHITE COPY (FINAL) GREEN COPY (FINAL) YELLOW INSPECTION COPY (INITIAL) PINK CONNECTION COPY (INITIAL)