IREDELL COUNTY HEALTH DEPARTMENT

STATESVILLE 704-878-5305 MOORESVILLE 704-664-5281

49000

IMPROVEMENT PERMIT / CERTIFICATE OF COMPLETION / OPERATION PERMIT / EXISTING SYSTEM INSPECTION

PROPERTY DESCRIPTION NO. 17036 DATE 10-8-93 TAX MAP NO. 3F-8-A-9

OWNER OR CONTRACTOR Wallace Lathe PHONE: Business Home (704) 537-9943

ADDRESS 9100 Harrisburg Rd. Charlotte, NC. 28215

LOCATION From Trowtman take Perth Rd. 5th Lot on R after Perthwood S/D entrance

SUBDIVISION Perthwood Estates BLOCK / SECTION LOT 9 LOT AREA 225'X 110' SITE CLASS. P.S. L.T.A.R. .35gpd/ftz

Water Supply: ✓Individual ☐ Community Public Well To Be Located

Septic Tank: 1000 min. Gallons; STB 825 Date 4-20-94

Pump Tank: — Gallons; PT — Date —

Nitrification Field: No Fields 1 Square Feet 1035 Linear Feet 345'

No Lines 6 Trench Width 36" Trench Depth 18"-28" Gravel Depth 12"

✓New System ☐ Repair System Type: I. (II) III. IV. V.

System Description: Conventional, gravity

Repair System Description: gravity PPBPS

Maintenance Agreement Required: ☐ Yes ✓No

✓House/Mod. Home ☐ Mobile Home ☐ Business ☐ Other


No. Bedrooms 3 No. Bathrooms 2 No. Employees —

Garbage Disposal: ✓Yes ☐No Auto. Dishwasher: ✓Yes ☐No Auto. Washing Machine: ✓Yes ☐No Other

☐ Slab ✓Crawl Space ☐ Basement w/plumbing ☐ Basement wo/plumbing

Comments Saprolite reclassified as P.S., INSTALL SYSTEM SHALLOW (no deeper than 28" to trench bottom. Keep Nitrification lines on contour. Keep system 10' from all property lines, 5' from fountation of home, and Keep system 50' min from any well. 100% Repair Area below system, PPBPS, gravity fed.

INITIAL SITE SKETCH

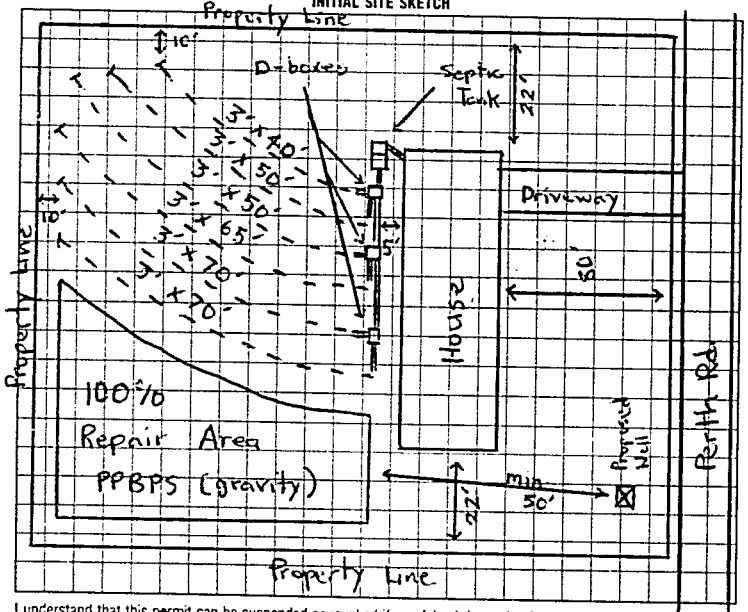

AS BUILT SKETCH

SAME AS INITIAL SKETCH

* Home not built at time of inspection, Keep home, min. 5' from any part of septic system

- Well located, it is recommend and required distance from system.

I understand that this permit can be suspended or revoked if any false information is supplied toward securing the permit/any unauthorized changes are made to the site/any unauthorized changes are made in the installation of the system. Improvement Permit is valid for 60 months from date of issuance.

Signed:

Improvement Permit by: Michael J. Dennis date 10-8-93

Existing System Inspection by: date

Installed by: Richard Abercrathy

Certificate of Completion by: Michael J. Dennis date 6-24-94

Operation Permit by: date

HEALTH DEPT. COPY: WHITE INSPECTION COPY (FINAL): GREEN OWNER COPY (FINAL): YELLOW INSPECTION COPY (INITIAL): PINK OWNER COPY (INITIAL): GOLD

26000