17035

48896

IREDELL COUNTY HEALTH DEPARTMENT

STATESVILLE 704-878-5305 MOORESVILLE 704-664-5281

IMPROVEMENT PERMIT / CERTIFICATE OF COMPLETION / OPERATION PERMIT / EXISTING SYSTEM INSPECTION

PROPERTY DESCRIPTION NO. 17035 DATE 9-29-93 TAX MAP NO. 3F-8-A-8

OWNER OR CONTRACTOR Wallace Lathe PHONE: Business Home 537-9943

ADDRESS 9100 Harrisburg Rd. Charlotte, N.C. 28215

LOCATION From Troutman Take Perth Rd. 4th lot on R after perthwood S/D entrance.

SUBDIVISION Perthwood Estates BLOCK / SECTION LOT 8 LOT AREA 229' X 110' SITE CLASS. P.S. L.T.A.R. .35 gpd/ft²

Water Supply: ✓Individual ☐ Community ☐ Public Well To Be Located.

Septic Tank: 1000 Gallons: STB 825 Date 5-6-94

Pump Tank: — Gallons: PT — Date —

Nitrification Field: No Fields 1 Square Feet 1035 Linear Feet 345'

No Lines 4 Trench Width 36" Trench Depth 18"-30" Gravel Depth 12"

☐ New System ☐ Repair System Type: I (II) III IV V VI

System Description: Conventional, gravity

Repair System Description: gravity, PPBPS

Maintenance Agreement Required: ☐ Yes ☐ No

✓House/Mod. Home ☐ Mobile Home ☐ Business ☐ Other

No. Bedrooms 3 No. Bathrooms 2 No. Employees —

Garbage Disposal: ✓Yes ☐ No

Auto. Dishwasher: ✓Yes ☐ No


Auto. Washing Machine: ✓Yes ☐ No

Other


☐ Slab ✓Crawl Space ☐ Basement w/plumbing ☐ Basement wo/plumbing

Comments INSTALL SYSTEM SHALLOW (no deeper than 30" to trench bottom) Add cover over d-boxes and lines (start of lines) to keep same amount of cover over system. Keep Nitrification lines on or as close to contour as possible. Keep system 5' from foundation of home, 10' from all property lines, and keep well min. 50' from any septic system. 100% Repair Area below initial system (gravity PPBPS).

INITIAL SITE SKETCH

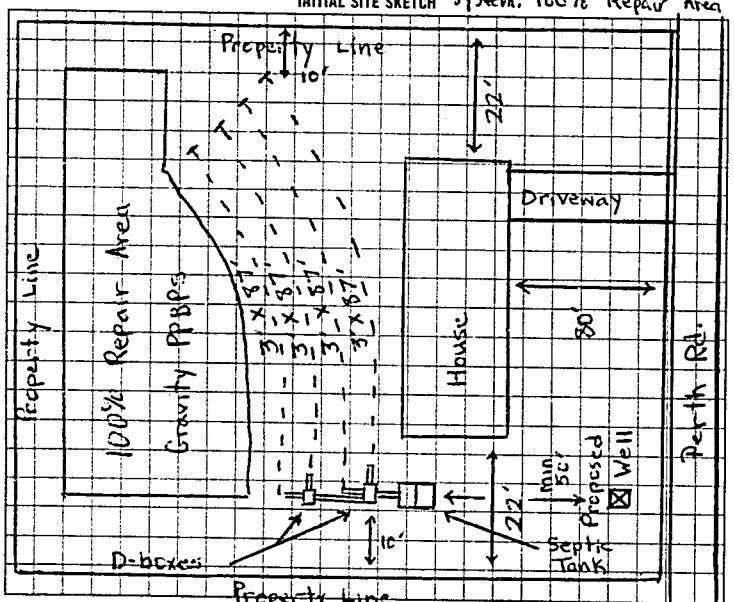

AS BUILT SKETCH

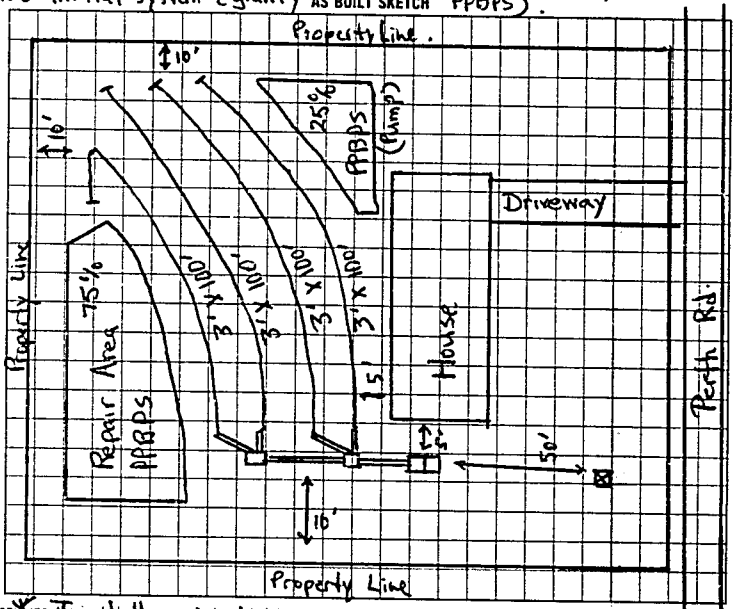

I understand that this permit can be suspended or revoked if any false information is supplied toward securing the permit/and ~~that~~ unauthorized changes are made to the site. Improvement Permit is valid for 60 months from date of issuance.

Signed:

Improvement Permit by: Michael Q. Dennis date 9-29-93

Existing System Inspection by: date

✓Trench falls as installed 400' instead of 345' Repair Area may not be quite 100%.

Installed by: Richard Abernathy

Certificate of Completion by: Michael Q. Dennis date 6-24-94

Operation Permit by: date

HEALTH DEPT. COPY WHITE OWNER COPY (FINAL) YELLOW INSPECTION COPY (INITIAL) PINK OWNER COPY (INITIAL) GOLD

0 2 6 0 0 0