IREDELL COUNTY HEALTH DEPARTMENT

STATESVILLE 704-878-5305 MOORESVILLE 704-664-5281

IMPROVEMENT PERMIT / AUTHORIZATION TO CONSTRUCT / OPERATION PERMIT / EXISTING SYSTEM INSPECTION

PERMIT# 88327 PIN# 473055 7691 PT DATE April 6, 2000

OWNER OR CONTRACTOR Billy Little PHONE: Business 902 3772 Home

ADDRESS 638 old NTB Rd Statesville NC

LOCATION Hwy 21 ST (R) Perth Rd past State Park Rd Apx ¼ on R, IT @ First Concrete Drive Right Property on left behind house

SUBDIVISION BLOCK / SECTION LOT LOT AREA SITE CLASS PS DESIGN FLOW 360 L.T.A.R. .3

Septic Tank: 1000 Gallons; STB 312 Date 12-30-01
Pump Tank: Gallons; PT Date
Pump Make: Model Serial No.
Nitrification Field: No Fields 1 Square Feet 1200 Linear Feet 400
No Lines 4 Trench Width 36" Max Trench Bottom Depth 36" Gravel Depth 12"

☒ New System ☐ Repair System Type: I (II) III. IV. V. VI
System Description: Conv. GRAVITY
Repair System Description: SAME / Pump Pass, big
Maintenance Agreement Required: ☐ Yes ☒ No
☐ Slab ☒ Crawl Space ☐ Basement w/plumbing ☐ Basement wo/plumbing


☒ House/Mod. Home No. Bedrooms 3
☐ Mobile Home No. Bathrooms 2
☐ Business No. Employees
☐ Other

Water Supply: ☒ Individual ☐ Public ☐ Community
WELL


Comments/Conditions: INSTALL Lines on contour
LOCATE well 100Ft from Septic System
NOT TO SCALE
PL 400

Comments/Conditions: SYSTEM INSTALLED WITH POLYLOK FILTER + MARKER

INITIAL SITE SKETCH

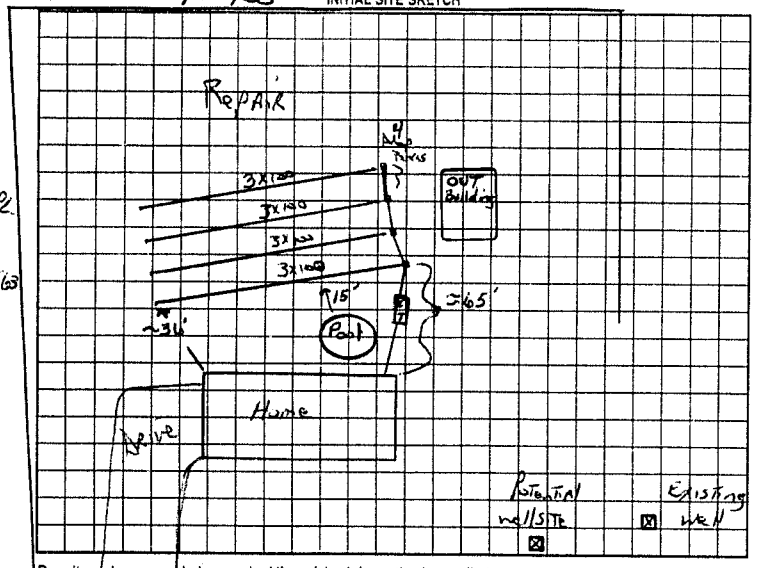

AS BUILT SKETCH

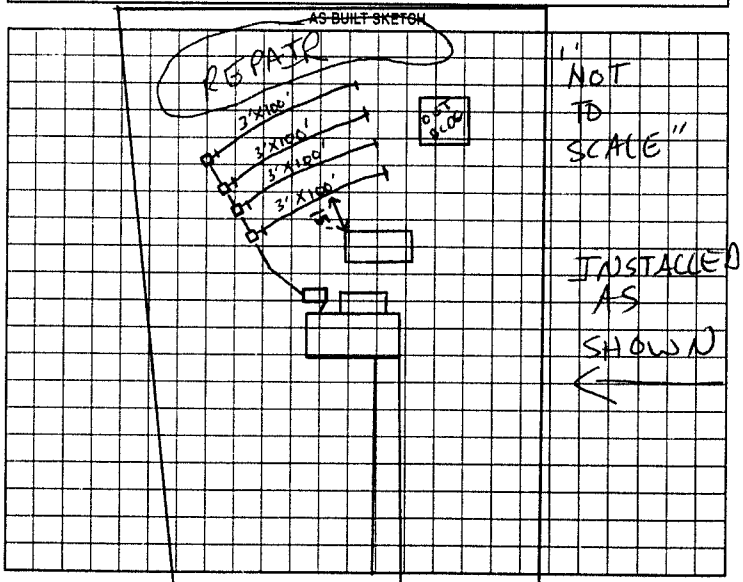

Permit can be suspended or revoked if any false information is supplied toward securing the permit/any unauthorized changes are made to the site/any unauthorized changes are made in the installation of the system. Improvement Permit with plat valid without expiration. Improvement Permit with site plan valid for sixty months. Authorization to Construct is valid for a period equal to that of Improvement Permit – not to exceed sixty months.

Signed: Billy Little date May 10, 2000 Installed by: LARRY BEAM

Improvement Permit by: J. Potter date Apr 16 2000 Operation Permit by: Jim Cook RSF date 5-31-01

Authorization to Construct by: J. Potter date Apr 16 2000 Existing System Inspection by: date

HEALTH DEPT. COPY: WHITE OWNER COPY (FINAL): YELLOW OWNER COPY (INITIAL) PINK