IREDELL COUNTY HEALTH DEPARTMENT

STATESVILLE 704-878-5305 MOORESVILLE 704-664-5281

IMPROVEMENT PERMIT / AUTHORIZATION TO CONSTRUCT / OPERATION PERMIT / EXISTING SYSTEM INSPECTION

PERMIT# 153321 PIN# 4732654881 DATE 11-7-08

OWNER OR APPLICANT Kimberly DAWN MEWSTER BENFIELD PHONE: Business 704-880-3068 Home

ADDRESS 114 MEWSTER DR Troutman NC 28166

LOCATION PERTH RD SOUTH (L) 1007 Perth Rd BY Skippers Cove

SUBDIVISION BLOCK / SECTION LOT LOT AREA 1.548 SITE CLASS. PS DESIGN FLOW 360 L.T.A.R. .3

Septic Tank: 1000 Gallons: STB 1007 Date 6-23-05
Pump Tank: Gallons: PT Date
Pump Make: Model Serial No.
Nitrification Field: No Fields 1 Square Feet EV=1200' Linear Feet 300'
No Lines 3@100' Trench Width 36" Max Trench Bottom Depth 33"

☒ New System ☐ Repair ☐ Expansion System Type: I (II) III IV V VI
System Description: 25% REDUCTION GRAVITY
Repair System Description: SAME
Maintenance Agreement Required: ☐ Yes ☒ No

☒ House/Mod. Home No. Bedrooms 3
☐ Mobile Home No. Persons
☐ Business No. Employees
☐ Other


Water Supply: ☒ Individual ☐ Public ☐ Community

Gravel Depth ALT ☒ Gravity ☐ Pressure ☐ Slab ☐ Crawl Space ☒ Basement w/plumbing ☐ Basement wo/plumbing


Comments:/Conditions: ① Keep FALL from Home to tank
② No signs of failure at time of check
③ Septic Field has an offsite easement on the adjacent lot

Comments:/Conditions: ZABEL F. Htr

INITIAL SITE SKETCH

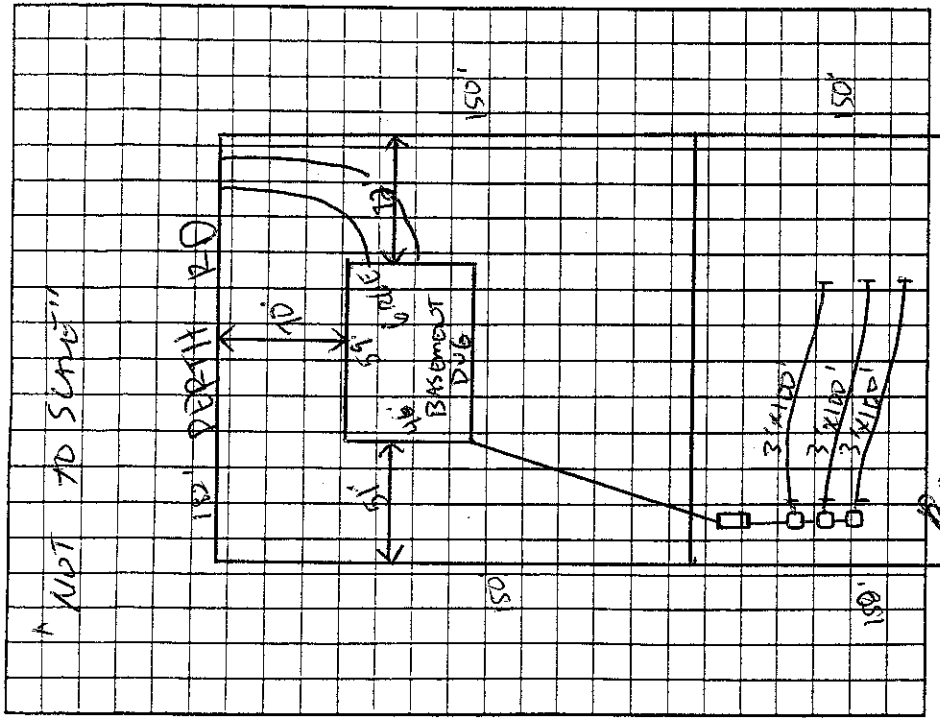

AS BUILT SKETCH

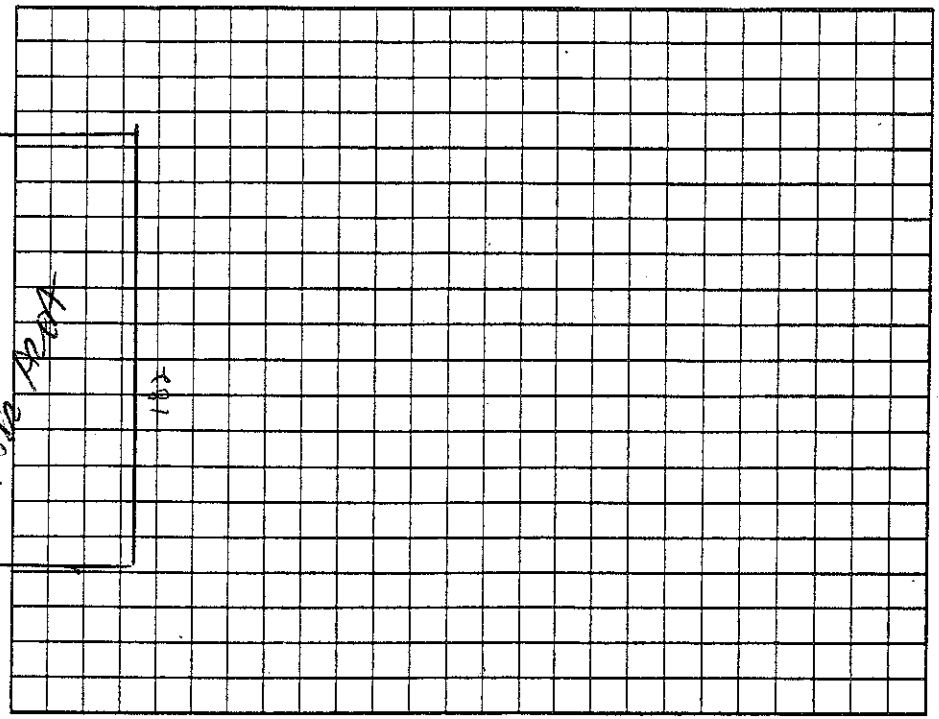

Permit can be suspended or revoked if any false information is supplied toward securing the permit/any unauthorized changes are made to the site/any unauthorized changes are made in the installation of the system. Improvement Permit with plat valid without expiration ☐ Improvement Permit with site plan valid for sixty months ☐ Authorization to Construct is valid for a period equal to that of Improvement Permit – not to exceed sixty months.

Signed: [signature] date 11-7-08 Installed by:

Improvement Permit by: date Operation Permit by: date

Authorization to Construct by: date Existing System Inspection by: [signature] date 11-7-08

HEALTH DEPT. COPY: WHITE OWNER COPY (FINAL): YELLOW OWNER COPY (INITIAL): PINK