# IREDELL COUNTY HEALTH DEPARTMENT

STATESVILLE 704-878-5305 (2) MOORESVILLE 704-664-5281

## IMPROVEMENT PERMIT / AUTHORIZATION TO CONSTRUCT / OPERATION PERMIT / EXISTING SYSTEM INSPECTION

PERMIT# 120734 PIN# 4730-65-4969 DATE 6-7-04

OWNER OR CONTRACTOR William & Peggy Menster PHONE: Business 704-450-3022 Home 704-528-6340

ADDRESS 114 MENSTER DR TROUTMAN, NC 28166

LOCATION 21 SOUTH, (2) PERTH (1) PASTE MENSTER DR @ BOX # 997

SUBDIVISION W.T. MENSTER BLOCK / SECTION ____ LOT 1 LOT AREA .59AC SITE CLASS. PS DESIGN FLOW 360 L.T.A.R. .3

Septic Tank: 1000 Gallons; STB 10 Date 3-10-04
Pump Tank: ____ Gallons; PT ____ Date ____
Pump Make: ____ Model ____ Serial No. ____
Nitrification Field: No Fields 1 Square Feet EQ=1200' Linear Feet 300'
No Lines 4x75' Trench Width 36" Max Trench Bottom Depth 36" Gravel Depth N/A

[X] New System [ ] Repair System Type: I, II, (III) IV, V, VI
System Description: 60AN 250L 1200
Repair System Description: LP PAPER
Maintenance Agreement Required: [ ] Yes [X] No


[X] House/Mod. Home No. Bedrooms 3
[ ] Mobile Home No. Bathrooms 2
[ ] Business No. Employees ____
[ ] Other ____
[ ] Slab [X] Crawl Space [ ] Basement w/plumbing [ ] Basement wo/plumbing

Water Supply: [X] Individual [ ] Public [ ] Community

Comments/Conditions: (1) GRADE OUT FIELD TERRACES & HUMPS & BUMPS (2) INSTALL LINES ON CONTOURS DISTRIBUTION SEEBALLS

Comments/Conditions:
- 48 Infiltrator Chambers Installed
- Sim-Tech filter Installed
- Septic Tank risers Installed

INITIAL SITE SKETCH 1"=60'

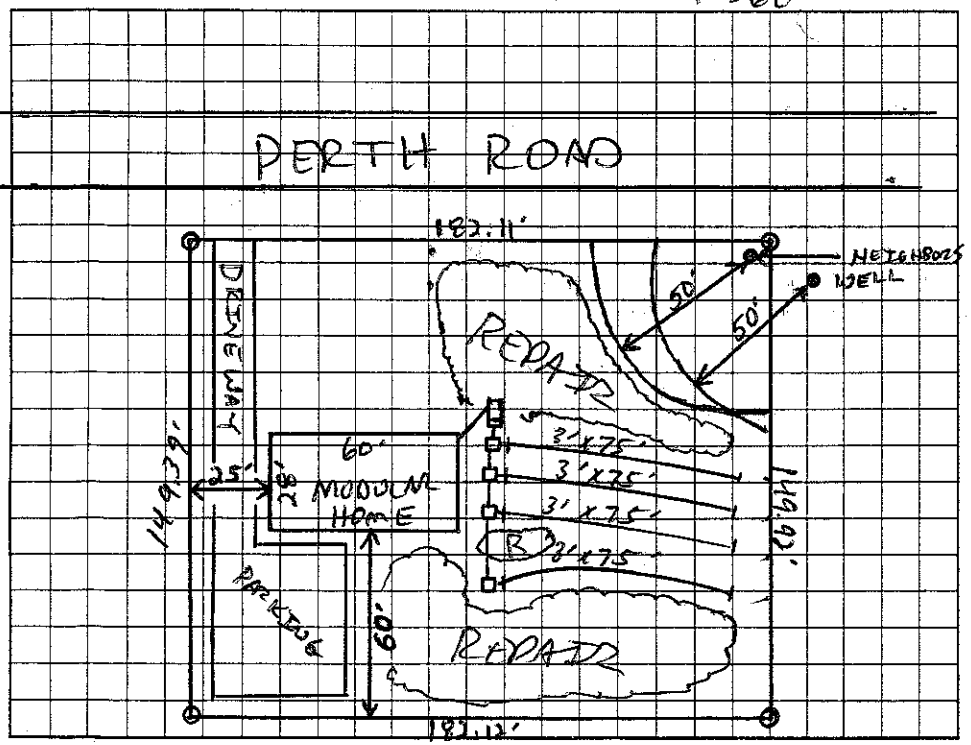


AS BUILT SKETCH

Installed As Shown per Initial Site Sketch

Permit can be suspended or revoked if any false information is supplied toward securing the permit/any unauthorized changes are made to the site/any unauthorized changes are made in the installation of the system. Improvement Permit with plat valid without expiration. Improvement Permit with site plan valid for sixty months. Authorization to Construct is valid for a period equal to that of Improvement Permit – not to exceed sixty months.

Signed: William Menster date 6/8/04
Improvement Permit by: [signature] date 6-7-04
Authorization to Construct by: [signature] date 6-7-04

Installed by: Wayne Frontz
Operation Permit by: William O. Johnson date 8/20/04
Existing System Inspection by: ____ date ____

HEALTH DEPT. COPY: WHITE OWNER COPY (FINAL): YELLOW OWNER COPY (INITIAL): PINK