IREDELL COUNTY HEALTH DEPARTMENT

STATESVILLE 704-878-5305 MOORESVILLE 704-664-5281

IMPROVEMENT PERMIT / AUTHORIZATION TO CONSTRUCT / OPERATION PERMIT / EXISTING SYSTEM INSPECTION

PERMIT# 19131 PIN# 4930 65 1977 DATE 1-29-99

OWNER OR CONTRACTOR Frank Hutchens PHONE: Business _____ Home 528 4687

ADDRESS PO Box 674 Troutman N.C.

LOCATION South on Perth Ch Rd on Rt past State Park Rd on Rt

SUBDIVISION _____ BLOCK / SECTION _____ LOT _____ LOT AREA 1.62 acres SITE CLASS PS DESIGN FLOW 360 L.T.A.R. .3

Septic Tank: 1000 Gallons: STB 312 Date 8-8-99
Pump Tank: _____ Gallons: PT _____ Date _____
Pump Make: _____ Model _____ Serial No _____
Nitrification Field: No Fields 1 Square Feet 1200 Linear Feet 400
No Lines 4 Trench Width 36" Max Trench Bottom Depth 36" Gravel Depth 12"

☑ New System ☐ Repair System Type: I ☑ II III IV V VI
System Description: Conv. Gravity
Repair System Description: " "
Maintenance Agreement Required: ☐ Yes ☑ No

☑ House/Mod. Home No. Bedrooms 3
☐ Mobile Home No. Bathrooms 2½
☐ Business No. Employees _____
☐ Other _____


☐ Slab ☑ Crawl Space ☐ Basement w/plumbing ☐ Basement w/o plumbing

Water Supply: ☑ Individual ☐ Public ☐ Community


Comments/Conditions:
398'

Comments/Conditions
Proposed

INITIAL SITE SKETCH

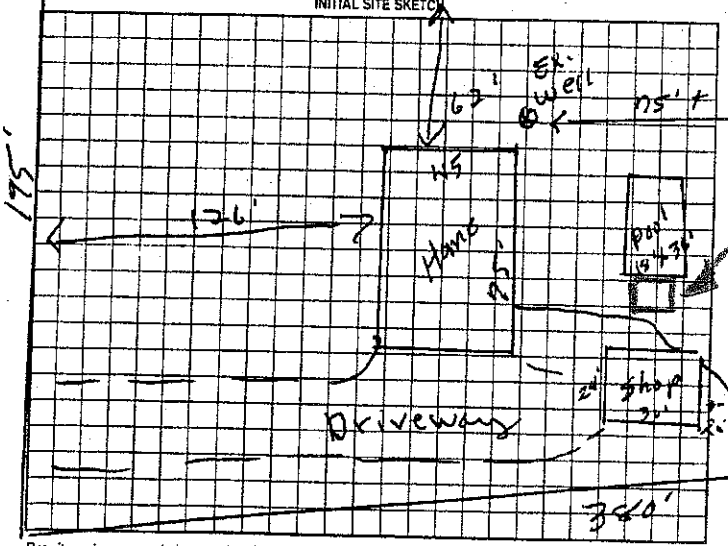

AS BUILT SKETCH

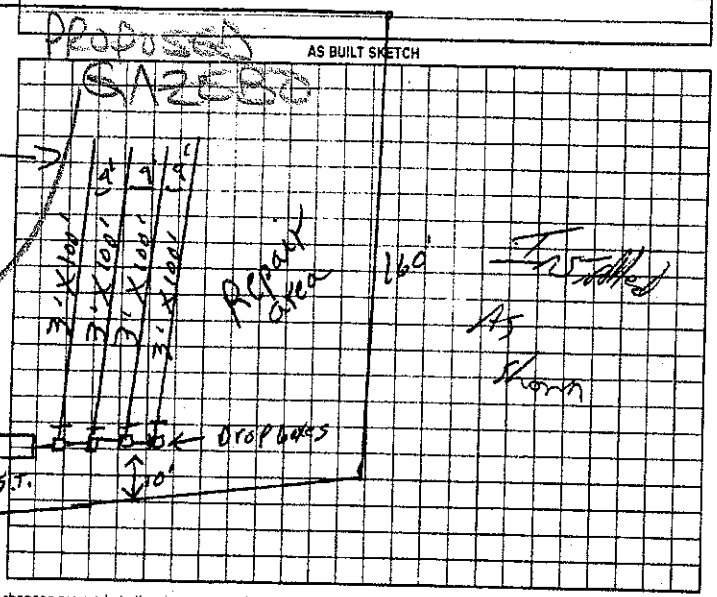

Permit can be suspended or revoked if any false information is supplied toward securing the permit/any unauthorized changes are made to the site/any unauthorized changes are made in the installation of the system. Improvement Permit with plat valid without expiration. Improvement Permit with site plan valid for sixty months. Authorization to Construct is valid for a period equal to that of Improvement Permit – not to exceed sixty months.

Signed: X J. S. Hutchens date _____ Installed by: Orbison & Sons

Improvement Permit by: R. C. Moore date 1-29-99 Operation Permit by: A Potter date 6/12/99

Authorization to Construct by: R. C. Moore date 1-29-99 Existing System Inspection by: _____ date _____

HEALTH DEPT COPY WHITE OWNER COPY (FINAL) YELLOW OWNER COPY (INITIAL) PINK

The location of the proposed GAZEBO addition does not appear to impact the existing septic system. **NOTE:

R. STEVE HENRICK REHS
Date: APRIL 12, 2011
ICHD-Environmental Health Division