# IREDELL COUNTY HEALTH DEPARTMENT

STATESVILLE 704-878-5305 MOORESVILLE 704-664-5281

## IMPROVEMENT PERMIT / AUTHORIZATION TO CONSTRUCT / OPERATION PERMIT / EXISTING SYSTEM INSPECTION

PERMIT# 100903 PIN# 4730 66 5124 DATE 6/22/01

OWNER OR CONTRACTOR Terri Bartlett PHONE: Business Home 664-7595

ADDRESS 269 Johnson Dairy Rd. Mooresville NC 28115

LOCATION Perth Rd, approx. 1mi North of Skippers on Lt

SUBDIVISION BLOCK / SECTION LOT LOT AREA +83 AC SITE CLASS PS DESIGN FLOW 360 L.T.A.R. 0.3

Septic Tank: 1000 Gallons. STB 825 Date 3-12-01
Pump Tank: Gallons; PT Date
Pump Make: Model Serial No.
Nitrification Field: No Fields 1 Square Feet 1200 Linear Feet 460
No Lines 5@80' Trench Width 36" Max Trench Bottom Depth 36" Gravel Depth 12"

X New System ☐ Repair System Type: I (II) III. IV. V. VI
System Description: Gravity Conventional
Repair System Description: Same
Maintenance Agreement Required: ☐ Yes X No
☐ Slab X Crawl Space ☐ Basement w/plumbing ☐ Basement wo/plumbing


☐ House/Mod. Home No. Bedrooms 3
X Mobile Home No. Bathrooms 2
☐ Business No. Employees
☐ Other

Water Supply: X Individual ☐ Public ☐ Community


Comments/Conditions: Install Lines on Contour - Can use Distribution Box or Drop Boxes

Comments/Conditions: POLYLOK FILTER & SAVER INSTALLED AS SHOWN WITH DROP BOXES

INITIAL SITE SKETCH

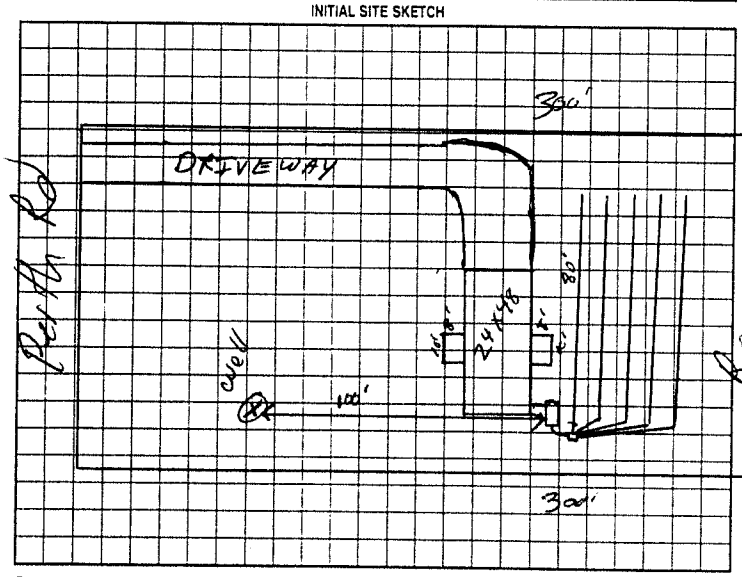


AS BUILT SKETCH

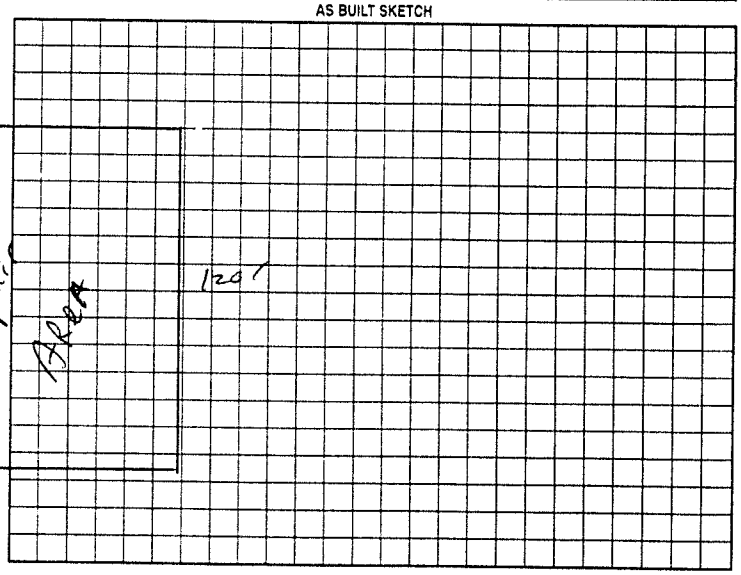


Permit can be suspended or revoked if any false information is supplied toward securing the permit/any unauthorized changes are made to the site/any unauthorized changes are made in the installation of the system. Improvement Permit with plat valid without expiration, Improvement Permit with site plan valid for sixty months. Authorization to Construct is valid for a period equal to that of Improvement Permit – not to exceed sixty months.

Signed: Terri S. Bartlett date 6-25-01 Installed by: DELBERT BOSTIAN

Improvement Permit by: RSF date 6/22/01 Operation Permit by: RSF date 7-19-01

Authorization to Construct by: RSF date 6/22/01 Existing System Inspection by: date

HEALTH DEPT COPY: WHITE OWNER COPY (FINAL) YELLOW OWNER COPY (INITIAL) PINK