IREDELL COUNTY HEALTH DEPARTMENT

Statesville Phone TR 3-7271 Mooresville Phone NO 3-1271

PERMIT TO INSTALL SEPTIC TANK

Permit NO. _____ Permit Date June 14 1968

Owner Julian Smith Address Troutman R1

Installed By Clyde Hoke Address R7


Location of Property Perth Ch. Road - on left in Pines past old Perth Ch.

Tank		Capacity		Length of Lines		Fixtures	
Block	( )	1000	(✓)	225'	(✓)	No. of Baths	( )
Precast	(✓)	1250	( )	250'	( )	Dishwasher	( )
		1500	( )	Other _____		Garbage Grdr	( )
		Other _____				Other trailer	

NOTIFY HEALTH DEPARTMENT AT LEAST EIGHT HOURS BEFORE TANK IS TO BE INSPECTED.

Final Inspection _____ 19__ Approved ( ) Disapproved ( )

Remarks no well down this date - wooded

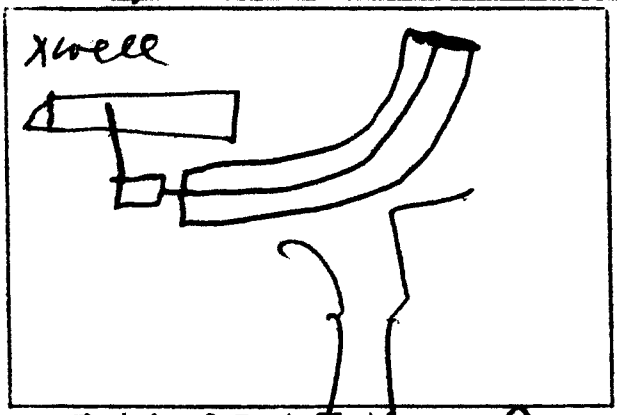

Sketch of Installation

Sanitarian