IREDELL COUNTY HEALTH DEPARTMENT

STATESVILLE 704-878-5305 MOORESVILLE 704-664-5281

53100

IMPROVEMENT PERMIT / CERTIFICATE OF COMPLETION / OPERATION PERMIT / EXISTING SYSTEM INSPECTION

PROPERTY DESCRIPTION NO. Town of Troutman DATE 10-7-94 TAX MAP NO. 3H-C-6 Watershed: ☐ Yes ☑ No

OWNER OR CONTRACTOR Jerry Ball PHONE: Business Home 528-6565

ADDRESS P.O. Box 66, Troutman, N.C. 28166

LOCATION From Troutman take Perth Rd. Tl 3rd Driveway past State Park Rd.

SUBDIVISION NA BLOCK / SECTION NA LOT NA LOT AREA ≈12.5 acres SITE CLASS. P.S. DESIGN FLOW 240 L.T.A.R. 3 sqd 1 ft²

Septic Tank: 1000 Gallons; STB 1012 Date 4-30-97

Pump Tank: — Gallons; PT — Date —

Pump Make: — Model — Serial No. —

Nitrification Field: No Fields 1 Square Feet 800 Linear Feet 266'

No Lines 2 Trench Width 36" Max Trench Bottom Depth 24"-30" Gravel Depth 12"

☑ New System ☐ Repair System Type: I, II, III, IV, V, VI

System Description: conventional, gravity fed

Repair System Description: " "

Maintenance Agreement Required: ☐ Yes ☑ No

☑ House/Mod. Home No. Bedrooms 2

☐ Mobile Home No. Bathrooms 2

☐ Business No. Employees

☐ Other


☐ Slab ☐ Crawl Space ☑ Basement w/plumbing ☐ Basement wo/plumbing

Water Supply: ☑ Individual ☐ Community ☐ Public

Comments: INSTALL SYSTEM SHALLOW (no deeper than 30" to trench bottom) Keep lines and trenches on contour Keep system min 5' from foundation of home, 25' from cut, and 100' from any well. Smooth off terraces (both), leave surface diversion on upperside to allow proper drainage.


Comments:

INITIAL SITE SKETCH

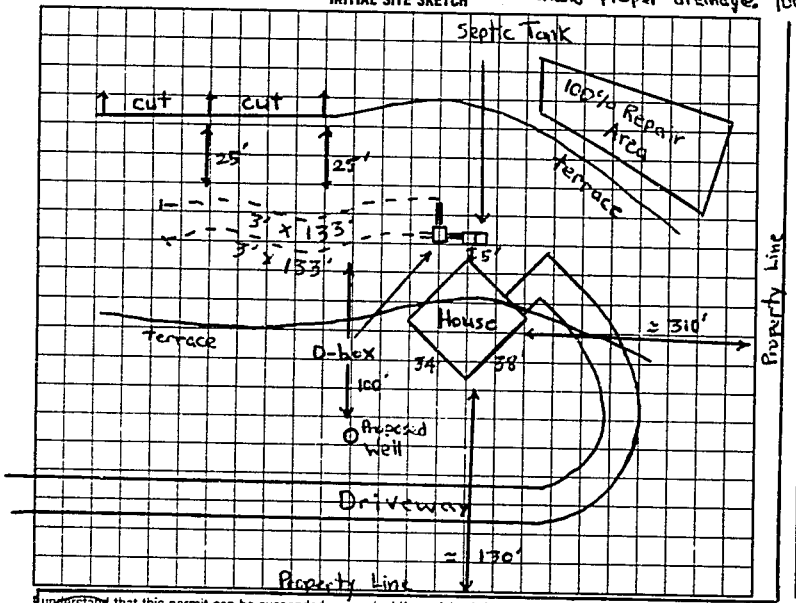

100% Repair Area below

AS BUILT SKETCH

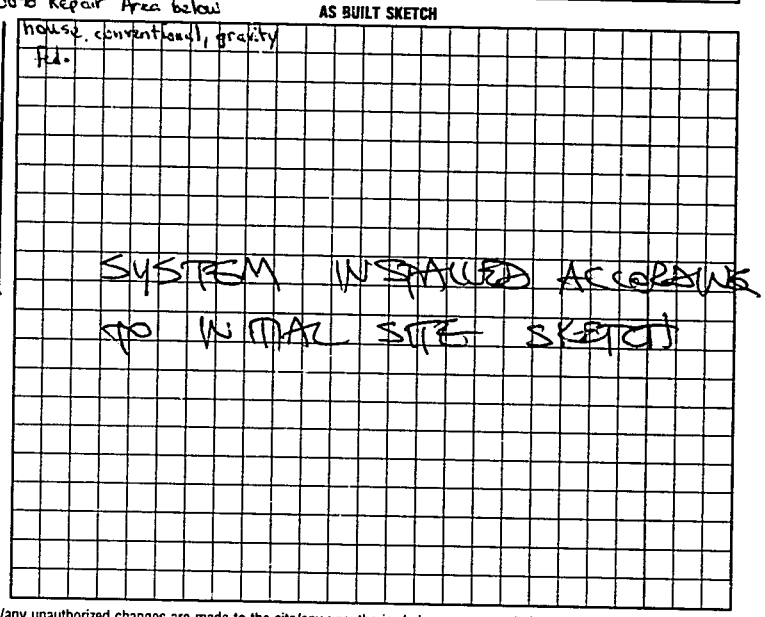

I understand that this permit can be suspended or revoked if any false information is supplied toward securing the permit/any unauthorized changes are made to the site/any unauthorized changes are made in the installation of the system. Improvement Permit is valid for 60 months from date of issuance.

Signed: X

Improvement Permit by: [signature] date 10-7-94

Existing System Inspection by: date

Installed by: DONALD LACKEY

Certificate of Completion by: date

Operation Permit by: STEVE HENDRICK date 6-25-97

HEALTH DEPT COPY: WHITE INSPECTION COPY (FINAL) GREEN OWNER COPY (FINAL) YELLOW INSPECTION COPY (INITIAL) PINK