IREDELL COUNTY HEALTH DEPARTMENT

STATESVILLE 704-878-5305 MOORESVILLE 704-664-5281

IMPROVEMENT PERMIT / AUTHORIZATION TO CONSTRUCT / OPERATION PERMIT / EXISTING SYSTEM INSPECTION

PERMIT# ✓ PIN# ✓ 4730-68-4153 DATE 3-18-05

OWNER OR CONTRACTOR GAIL HENDERSON PHONE: Business Home 704-508-2185

ADDRESS 889 PERTH RD TROUTMAN, NC 28166

LOCATION 21S @ PERTH @ AT BOX #889. ACROSS FROM STATE PARK RD

SUBDIVISION 1000 BLOCK / SECTION LOT LOT AREA 0.75 ac SITE CLASS. PS DESIGN FLOW 360 L.T.A.R. .5

Septic Tank: ~~EXCEPTION~~ Gallons; STB 994-1000 Date 3.29.05

Pump Tank: Gallons; PT Date

Pump Make: Model Serial No.

Nitrification Field: No Fields 1 Square Feet 1200' Linear Feet 400'

No Lines 4X100' Trench Width 36" Max Trench Bottom Depth 30-36"

☐ New System ☒ Repair System Type: I, II, III, IV, V, VI

System Description: REPAIR (ONLY 6 BDM)

Repair System Description:

Maintenance Agreement Required: ☐ Yes ☒ No

☒ House/Mod. Home ☐ Mobile Home ☐ Business ☐ Other

No. Bedrooms 3 No. Bathrooms 2 No. Employees


Water Supply: ☐ Individual ☒ Public ☐ Community

Gravel Depth 12" ☐ Slab ☐ Crawl Space ☒ Basement w/plumbing ☐ Basement wo/plumbing


Comments:/Conditions: ① CALL PRIOR [redacted] FOR CONSULTATIVE VISIT & FLAGOUT BEFORE INSTALLATION ② PUMP TANK, CHECK TEE, & REPLACE IF NECESSARY ③ INSTALL LINES ON CONTOURS & MAINTAIN SETBACKS

Comments:/Conditions: ④ THIS PERMIT SERVES AS NOTICE OF VIOLATION AND MUST BE REPAIRED WITHIN 30 DAYS. ⑤ INSTALL LINES BETWEEN 30-36" DEEP

INITIAL SITE SKETCH

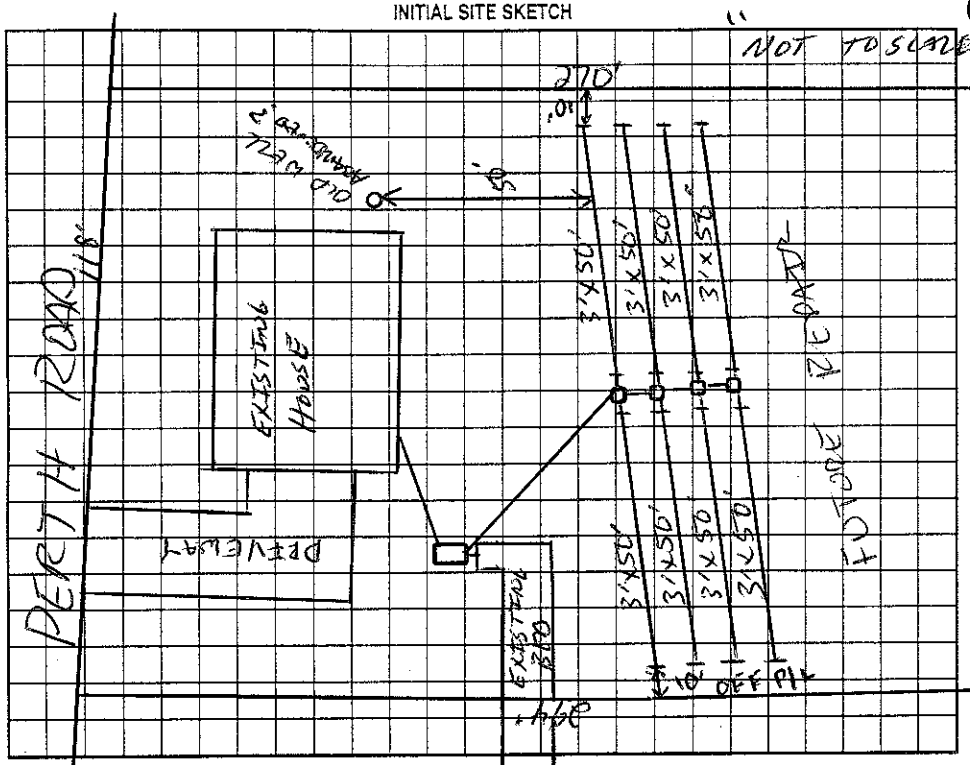

AS BUILT SKETCH

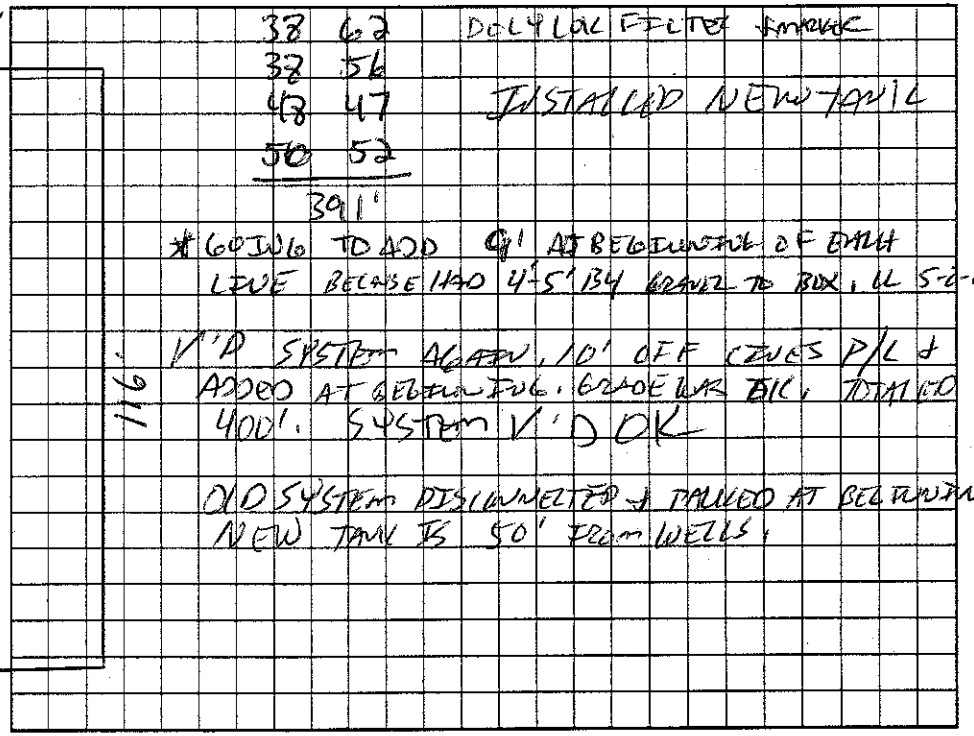

DOLPHIN FILTER SMOKE

INSTALLED NEW TANK

* 60 IN 6 TO ADD 4' AT BEGINNING OF EACH LINE BECAUSE HAD 4-5' BY GRAVEL TO BOX. LL 5-3-05

V'D SYSTEM AGAIN, 10' OFF CURVES P/L & ADDED AT BEGINNING. GRADE BAR BIC, TOTALED 400'. SYSTEM V'D OK

OLD SYSTEM DISCONNECTED & TANKED AT BEGINNING NEW TANK IS 50' FROM WELLS.

Permit can be suspended or revoked if any false information is supplied toward securing the permit/any unauthorized changes are made to the site/any unauthorized changes are made in the installation of the system. Improvement Permit with plat valid without expiration. Improvement Permit with site plan valid for sixty months. Authorization to Construct is valid for a period equal to that of Improvement Permit – not to exceed sixty months.

Signed: Gail Henderson date 3-18-05 Installed by: TUCKER

Improvement Permit by: [signature] date 3-18-05 Operation Permit by: [signature] date 5-3-05

Authorization to Construct by: [signature] date 3-18-05 Existing System Inspection by: date

HEALTH DEPT. COPY: WHITE OWNER COPY (FINAL): YELLOW OWNER COPY (INITIAL): PINK