This Voids All Previous Permits

IREDELL COUNTY HEALTH DEPARTMENT

STATESVILLE 704-878-5305
MOORESVILLE 704-664-5281

IMPROVEMENT PERMIT / AUTHORIZATION TO CONSTRUCT / OPERATION PERMIT / EXISTING SYSTEM INSPECTION

PERMIT# 02Z 999/87600 PIN# 4730685581 DATE Dec 30 99

OWNER OR CONTRACTOR Jeff LeVis PHONE: Business _____ Home 662 5587

ADDRESS 520 CATAWBA Ln STATESVILLE NC

LOCATION Old MTRd (T) PERTH Rd on Left before STATE PARK Rd ACROSS From CEMETERY.

SUBDIVISION Spicewood BLOCK / SECTION _____ LOT _____ LOT AREA .97Ac SITE CLASS PS DESIGN FLOW 360 L.T.A.R. .03

Septic Tank: 1000 Gallons; STB 1012 Date 2-23-00
Pump Tank: 1000 Gallons; P.T. 17 Date 10-22-00
Pump Make: HydroMatic Model SKA 50A1 Serial No. 51334046-7
Nitrification Field: No Fields 1 Square Feet 1200 Linear Feet 200
No Lines 5@40' Trench Width 24" Max Trench Bottom Depth 36" Gravel Depth N/A

☒ New System ☐ Repair System Type: I, II, ☒ III, IV, V, VI
System Description: Pump 50% Reduction
Repair System Description: SAME
Maintenance Agreement Required: ☐ Yes ☒ No
☐ Slab ☐ Crawl Space ☒ Basement w/plumbing ☐ Basement wo/plumbing


☒ House/Mod. Home No. Bedrooms 3
☐ Mobile Home No. Bathrooms 2.5
☐ Business No. Employees _____
☐ Other _____

Water Supply: ☐ Individual ☒ Public ☐ Community


Comments/Conditions: INSTALL on CONTOUR 46 PANELS 4/33 Ton Sand
Use Sch 80 pipe UNDER DRIVE Lime Side WALLS
See Attachment For pump information

Comments/Conditions: 5-16 Lines & Tanks INSTALLED AS Shown
Supply Line Relocated To Keep out of Repair
PRESSURE SET 5-16
5-26 Alan CK OK

INITIAL SITE SKETCH

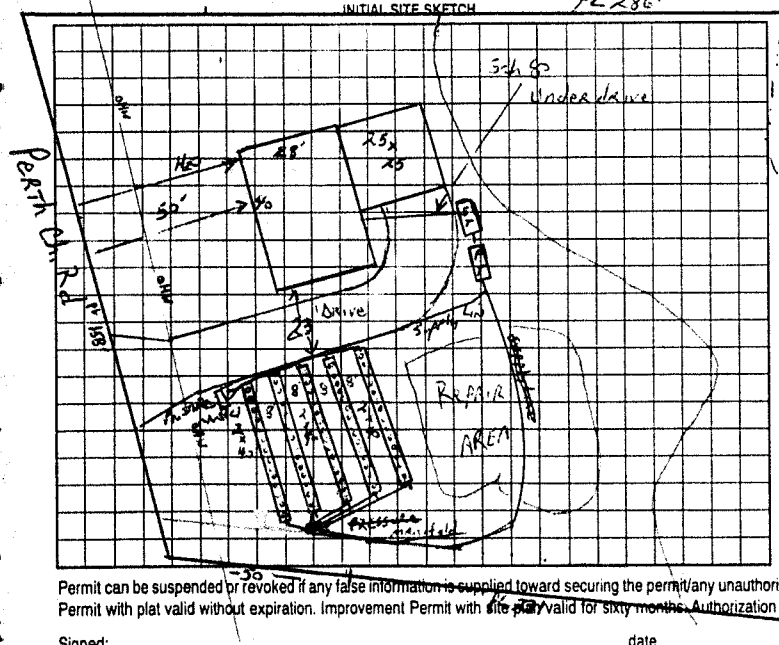

AS BUILT SKETCH

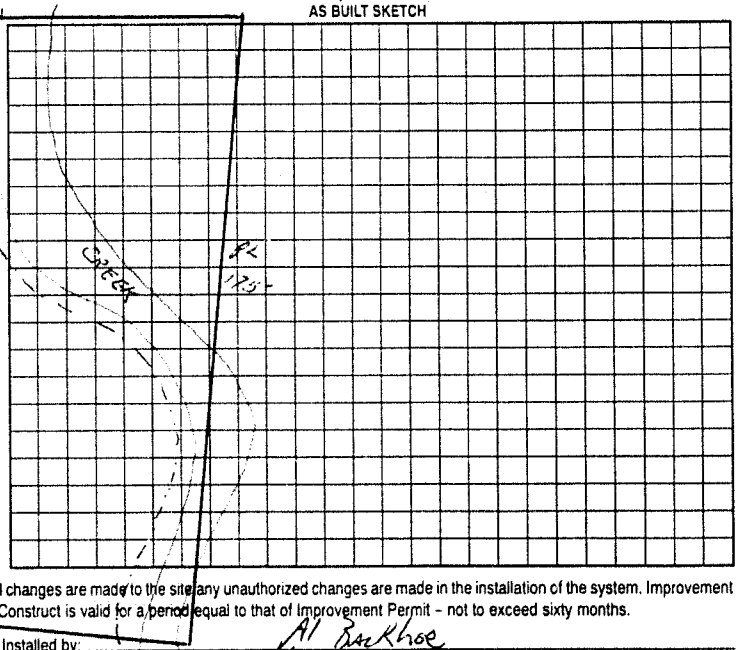

Permit can be suspended or revoked if any false information is supplied toward securing the permit/any unauthorized changes are made to the site/any unauthorized changes are made in the installation of the system. Improvement Permit with plat valid without expiration. Improvement Permit with site plan valid for sixty months. Authorization to Construct is valid for a period equal to that of Improvement Permit - not to exceed sixty months.

Signed: _____ date _____ Installed by: Al Backhoe

Improvement Permit by: JC Potter date Dec 30 99 Operation Permit by: JC Potter date May 01 2000

Authorization to Construct by: JC Potter date Dec 30 99 Existing System Inspection by: _____ date _____

HEALTH DEPT. COPY: WHITE OWNER COPY (FINAL): YELLOW OWNER COPY (INITIAL): PINK