IREDELL COUNTY HEALTH DEPARTMENT

Statesville Phone TR 3-7271 Mooresville Phone NO 3-1271

PERMIT TO INSTALL SEPTIC TANK

Permit NO. 136 Permit Date 4-16 1976

Owner Neill + Cloaty - Builder Address Trenton N C

Installed By Sam Pearce Address Harmony N C


Location of Property Turn right at ~~Traffic Light~~ in Trenton, go to road # 1391 Turn left house is first on right.

Tank		Capacity		Length of Lines		Fixtures	
Block	( )	1000	(✓)	225'	(✓)	No. of Baths	( )
Precast	(✓)	1250	( )	250'	( )	Dishwasher	( )
		1500	( )	Other		Garbage Grdr.	( )
		Other				Other	

NOTIFY HEALTH DEPARTMENT AT LEAST EIGHT HOURS BEFORE TANK IS TO BE INSPECTED.

Final Inspection 19 Approved (✓) Disapproved ( )

Remarks Installed on ~~[illegible]~~ filled in soil

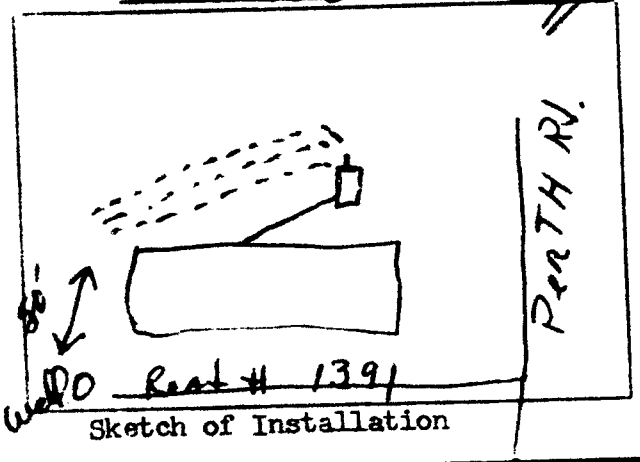

Sketch of Installation

Sanitarian