IREDELL COUNTY HEALTH DEPARTMENT

STATESVILLE 704-878-5305 (C) 300.00 Paid MOORESVILLE 704-664-5281

IMPROVEMENT PERMIT / AUTHORIZATION TO CONSTRUCT / OPERATION PERMIT / EXISTING SYSTEM INSPECTION

PERMIT# -2-105004 PIN# 3H-C-3 DATE 9/27/01

OWNER OR CONTRACTOR LARRY DAVIS PHONE: Business _____ Home _____

ADDRESS 450 OAK TREE MOORESVILLE NC 28117

LOCATION PERTH(S) - TL SPICEWOOD - TR SPICEWOOD - ON RT

SUBDIVISION SPICEWOOD BLOCK / SECTION _____ LOT 3 LOT AREA .15AC SITE CLASS PS DESIGN FLOW 360GPD L.T.A.R. .36PD/FT

Septic Tank: 1000 Gallons; STB 1007 Date 3-3-02
Pump Tank: 1000 Gallons; PT 274 Date 3-21-02
Pump Make: ZOELLER Model N137-0 Serial No 137.0002
Nitrification Field: No Fields 1 Square Feet 1080 Linear Feet 360
No Lines 4@90' Trench Width 36" Max Trench Bottom Depth 30" Gravel Depth N/A

☑ New System ☐ Repair System Type: I, II, III, IV, V, VI
System Description: PUMP 25% REDUCTION
Repair System Description: LP PANEL
Maintenance Agreement Required: ☐ Yes ☑ No


☑ House/Mod. Home No. Bedrooms 3
☐ Mobile Home No. Bathrooms 3
☐ Business No. Employees ____
☐ Other ____
☐ Slab ☑ Crawl Space ☐ Basement w/plumbing ☐ Basement wo/plumbing

Water Supply: ☐ Individual ☑ Public ☐ Community


Comments/Conditions:

Comments/Conditions: SEPTIC TANK WITH MARKER INSTALLED USING "POLYLOK" FILTER @ 25% REDUCTION SYSTEM INSTALLED USING 64 "BIODIFFUSER" CHAMBERS (400)

INITIAL SITE SKETCH 1"=50'

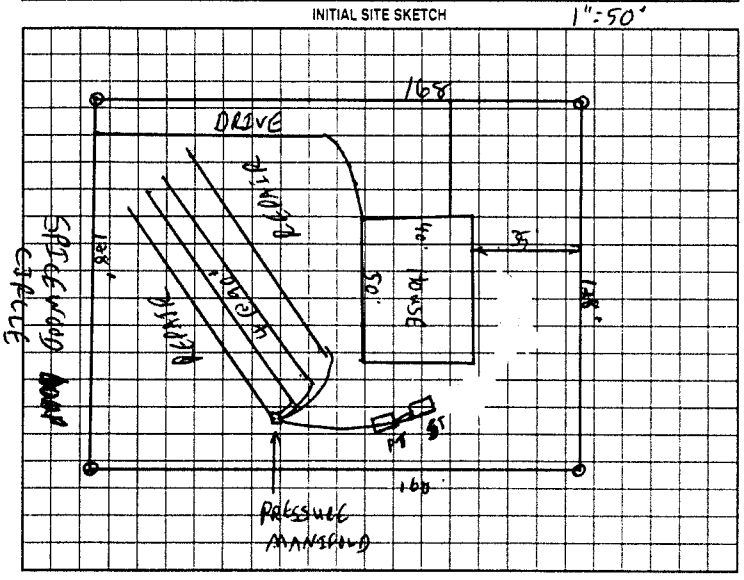

AS BUILT SKETCH

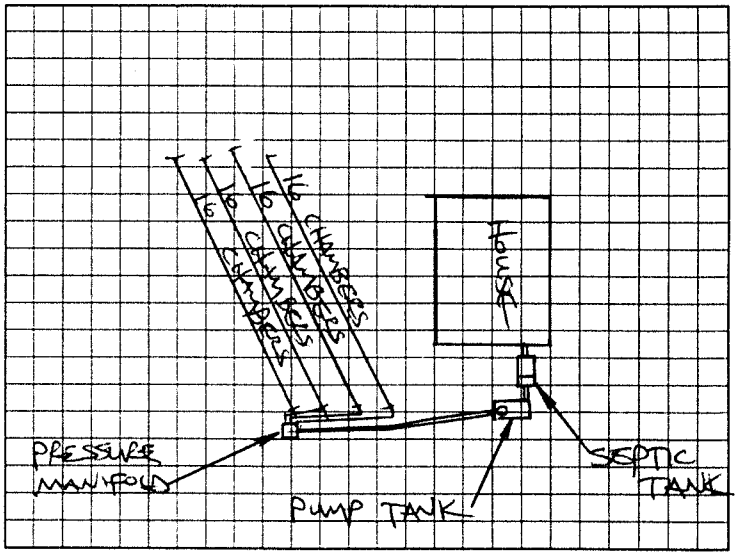

Permit can be suspended or revoked if any false information is supplied toward securing the permit/any unauthorized changes are made to the site/any unauthorized changes are made in the installation of the system. Improvement Permit with plat valid without expiration. Improvement Permit with site plan valid for sixty months. Authorization to Construct is valid for a period equal to that of Improvement Permit – not to exceed sixty months.

Signed: Larry H Davis date _____ Installed by: WAYNE CLONTZ

Improvement Permit by: [signature] date 9/27/01 Operation Permit by: STEVE HEDRICK date 9-17-02

Authorization to Construct by: STEVE HEDRICK date 1-17-02 Existing System Inspection by: _____ date _____

HEALTH DEPT. COPY: WHITE OWNER COPY (FINAL): YELLOW OWNER COPY (INITIAL): PINK