IREDELL COUNTY HEALTH DEPARTMENT

STATESVILLE 704-878-5305 MOORESVILLE 704-664-5281

IMPROVEMENT PERMIT / AUTHORIZATION TO CONSTRUCT / OPERATION PERMIT / EXISTING SYSTEM INSPECTION

PERMIT# 129547 PIN# 4730 70 5378 .024 4730-70-1035 DATE 10/11/06

OWNER OR APPLICANT BO of NC Inc. / HERITAGE HOMES PHONE: Business 704-489-4663 Home

ADDRESS 5734 Highway 150 East Denver, NC 28037

LOCATION Perth, N TL Windy Forest, on (R) after first intersection

SUBDIVISION Windy Forest BLOCK / SECTION 1 LOT 24 LOT AREA 1.932 SITE CLASS. PS DESIGN FLOW 480 L.T.A.R. .3

Septic Tank: 1000 Gallons; STB 350 Date 11/13/06

Pump Tank: 1000 Gallons; PT 318 Date 10/18/06

Pump Make: Little Giant Model EN-9 Serial No.

Nitrification Field: No Fields 1 Square Feet 1200 Linear Feet 400

No Lines 3@133 Trench Width 3' Max Trench Bottom Depth 36" Gravel Depth No

☒ New System ☐ Repair ☐ Expansion System Type: I II (III) IV V VI

System Description: PM → 250 Reduced

Repair System Description: 16" PPBDS - LP

Maintenance Agreement Required: ☐ Yes ☒ No

☒ House/Mod. Home ☐ Mobile Home ☐ Business ☐ Other

No. Bedrooms 4 No. Persons No. Employees

Water Supply: ☐ Individual ☐ Public ☒ Community

☐ Gravity ☒ Pressure ☐ Slab ☒ Crawl Space ☐ Basement w/plumbing ☐ Basement wo/plumbing

Comments:/Conditions: See attached Site Plan, System Design and Specification Sheet by Rollins Soil & Environmental Services.

Comments:/Conditions:

INITIAL SITE SKETCH

1) Copies of Site Plan & Specifications available from ICHD

2) No changes allowed without approval from ICHD.

AS BUILT SKETCH

Permit can be suspended or revoked if any false information is supplied toward securing the permit/any unauthorized changes are made to the site/any unauthorized changes are made in the installation of the system. Improvement Permit with plat valid without expiration ☐ Improvement Permit with site plan valid for sixty months ☐ Authorization to Construct is valid for a period equal to that of Improvement Permit – not to exceed sixty months.

Signed: * Wendy Laughlin date 10-13-06

Improvement Permit by: Wendy Sparks RS. date 10/11/06

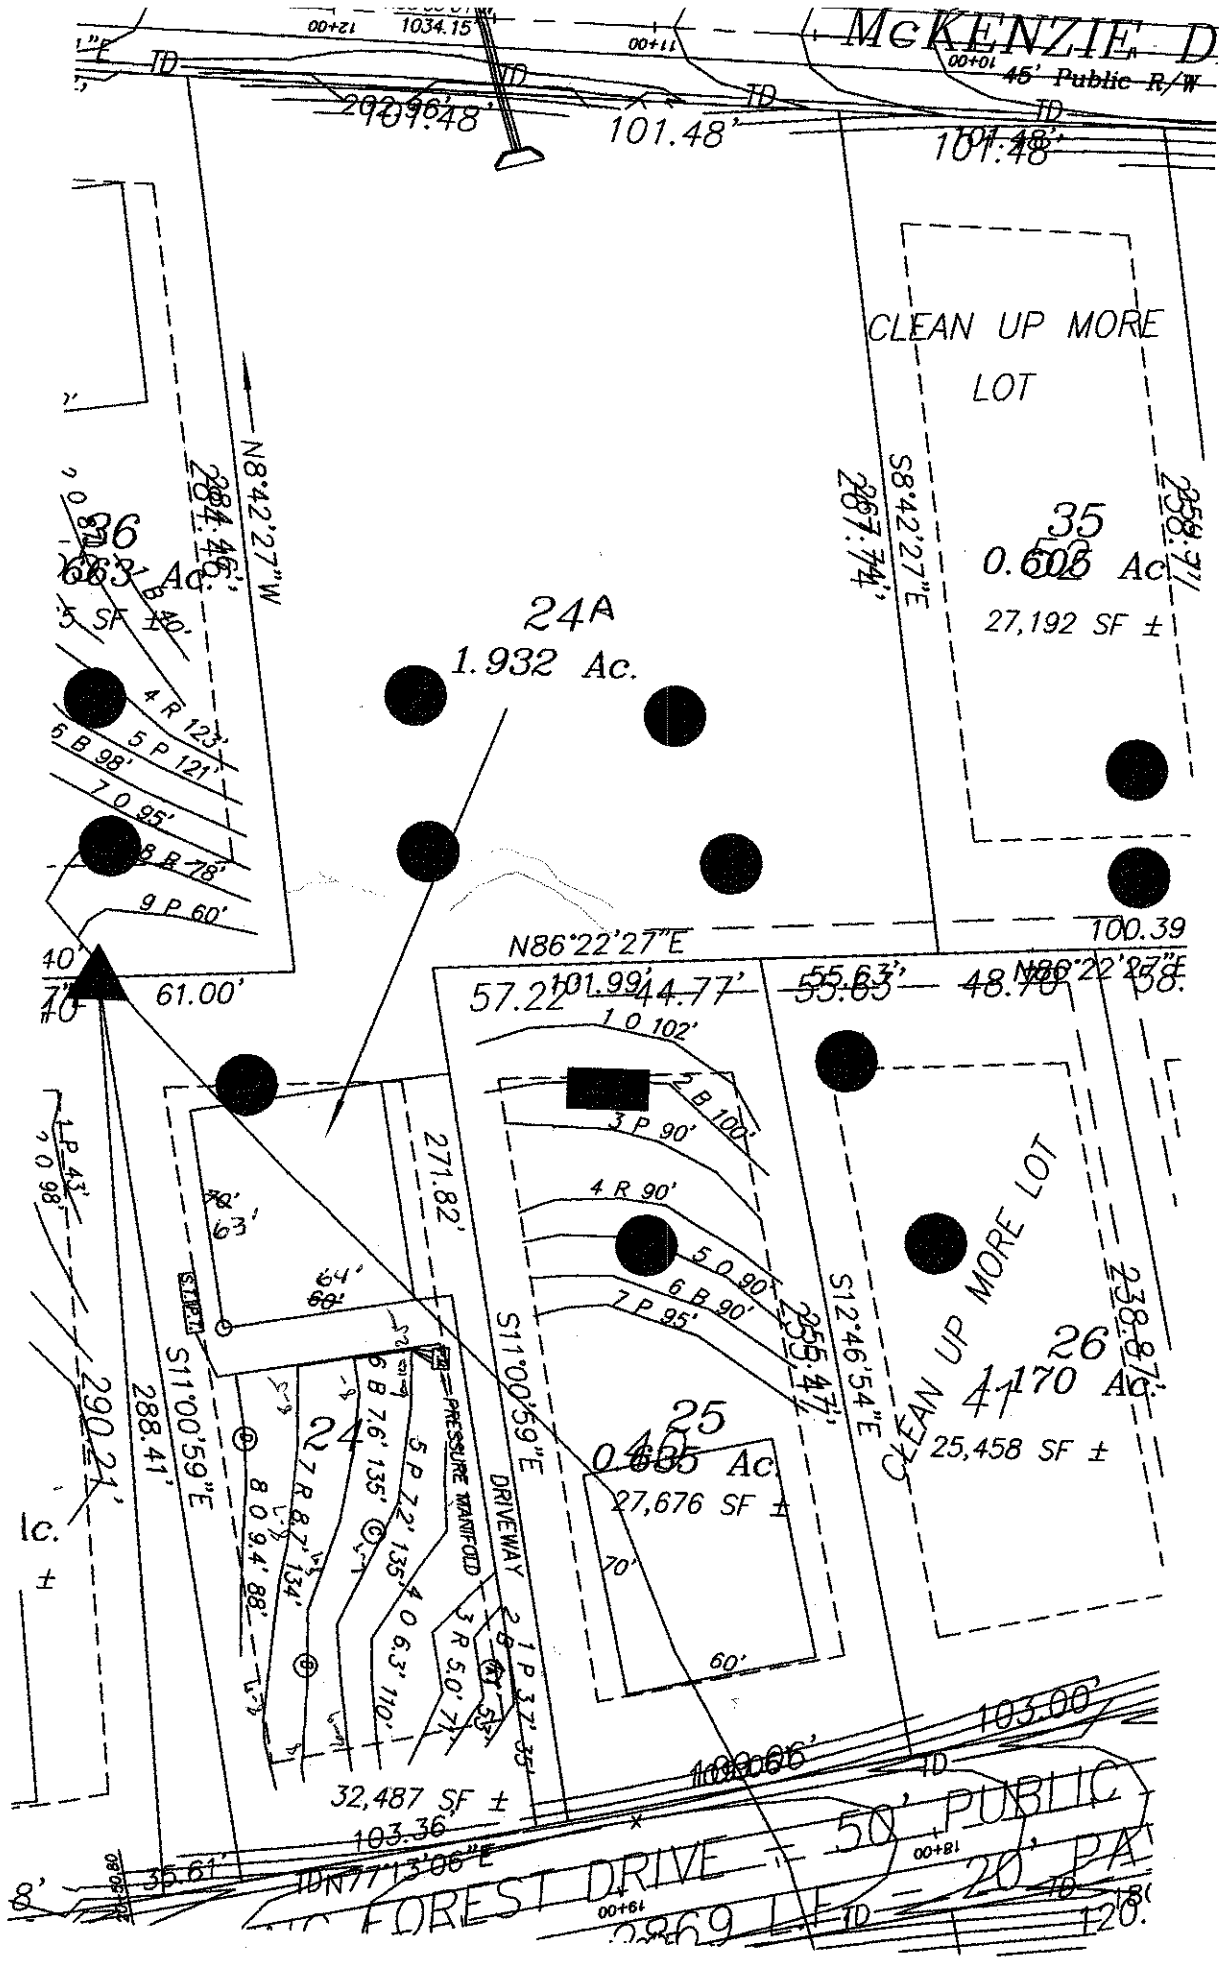
Authorization to Construct by: Wendy Sparks RS. date 1/4/07

Installed by: Randy Mathews - Piedmont Septic Tank

Operation Permit by: Wendy Sparks RS. date 8/8/08

Existing System Inspection by: date

HEALTH DEPT. COPY: WHITE OWNER COPY (FINAL): YELLOW OWNER COPY (INITIAL): PINK


McKENZIE D
45' Public R/W
101.48'
CLEAN UP MORE LOT
35
0.605 Ac.
27,192 SF ±
24A
1.932 Ac.
36
0.663 Ac.
N8°42'27"W
284.46'
S8°42'27"E
267.74'
N86°22'27"E
100.39'
61.00'
271.82'
S11°00'59"E
288.41'
290.21'
CLEAN UP MORE LOT
26
0.410 Ac.
25,458 SF ±
25
0.635 Ac.
27,676 SF ±
24
32,487 SF ±
PRESSURE MANIFOLD
DRIVEWAY
103.00'
103.36'
S77°13'06"E
35.61'
FOREST DRIVE - 50' PUBLIC
1" = 60'