IREDELL COUNTY HEALTH DEPARTMENT

Authorization to Construct 4730705842

STATESVILLE 704-878-5305 MOORESVILLE 704-664-5281

IMPROVEMENT PERMIT / ~~CERTIFICATE OF COMPLETION~~ / OPERATION PERMIT / EXISTING SYSTEM INSPECTION

PROPERTY DESCRIPTION NO. 24210 DATE 7/2/96 TAX MAP NO. 3F-9-4-35 Watershed: ☒ ~~Yes~~ ☐ No

OWNER OR CONTRACTOR Max Spears PHONE: Business _____ Home 636-7954

ADDRESS 60719 Henderson - Salisbury NC 28144

LOCATION Perth Rd - TL Shady Cove - Corner of Alfara Rd & Shady Cove Rd

SUBDIVISION Shady Cove BLOCK / SECTION _____ LOT 35 LOT AREA 1.8 ac SITE CLASS. PS DESIGN FLOW 300gpd L.T.A.R. 3gpd/ft²

Septic Tank: 1000 Gallons; STB 825 Date 7/16/96
Pump Tank: _____ Gallons; PT _____ Date _____
Pump Make: _____ Model _____ Serial No. _____
Nitrification Field: No Fields 1 Square Feet 1200 Linear Feet 400
No Lines 3 Trench Width 36" Max Trench Bottom Depth 36" Gravel Depth 12"

☒ New System ☐ Repair System Type: ☐ II ☐ III, IV, V, VI
System Description: Gravity Conv.
Repair System Description: _____
Maintenance Agreement Required: ☐ Yes ☒ No


☒ House/Mod. Home No. Bedrooms 3
☐ Mobile Home No. Bathrooms 2
☐ Business No. Employees _____
☐ Other _____
☐ Slab ☐ Crawl Space ☐ Basement w/plumbing ☒ Basement wo/plumbing

Water Supply:
☒ Individual
☐ Community
☐ Public


Comments:

Comments:

INITIAL SITE SKETCH

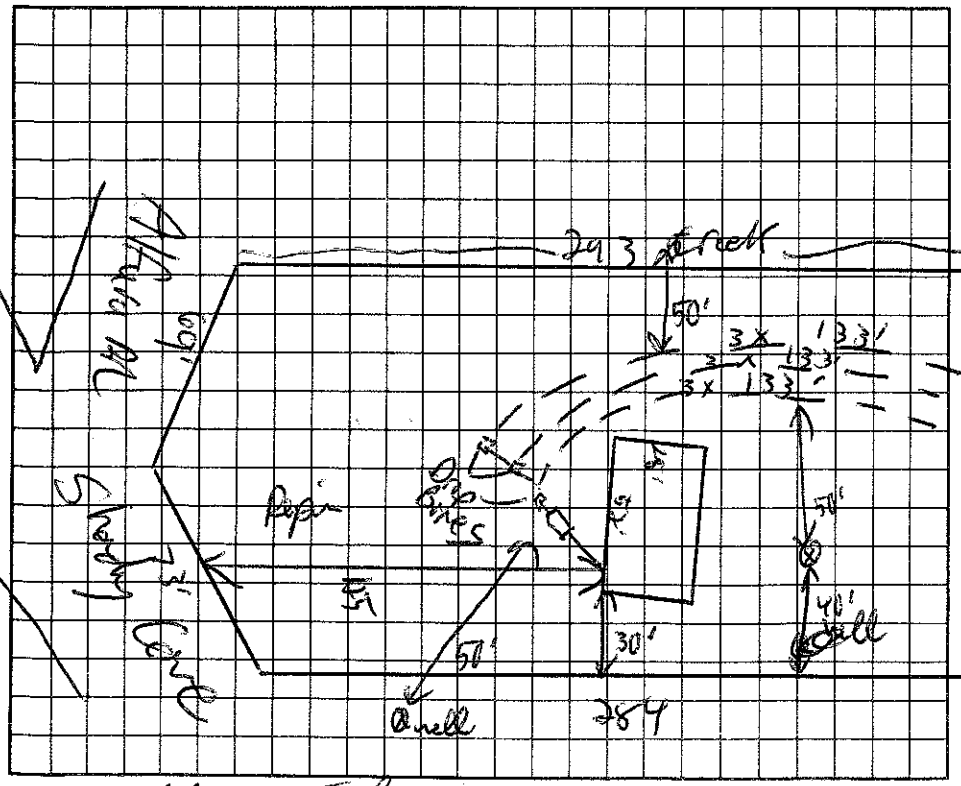

AS BUILT SKETCH

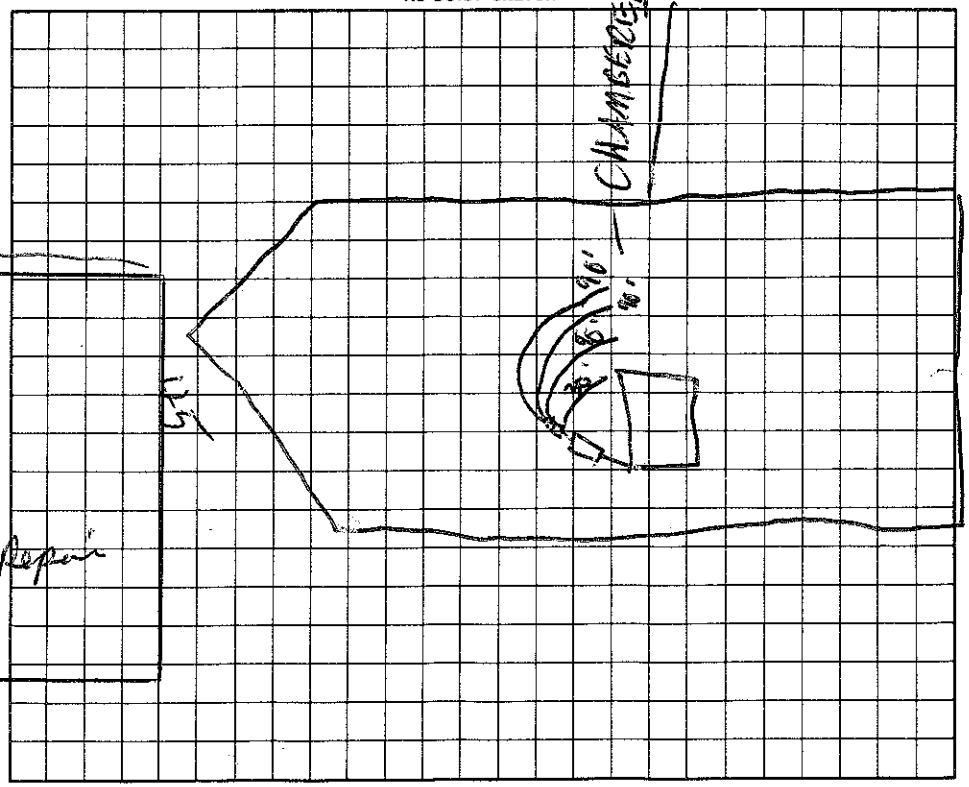

I understand that this permit can be suspended or revoked if any false information is supplied toward securing the permit/any unauthorized changes are made to the site/any unauthorized changes are made in the installation of the system.

Signed: Max Spears

Installed by: ROWAN SEPTIC

Improvement Permit by: C. Ruby Pearson EHSI date 7/3/96

Authorization to Construct ~~Existing System Inspection by~~: C. Ruby Pearson EHSI date 7/3/96

Certificate of Completion by: _____ date _____

Operation Permit by: C. Ruby Pearson date 9/28/96

HEALTH DEPT. COPY: WHITE INSPECTION COPY (FINAL): GREEN OWNER COPY (FINAL): YELLOW INSPECTION COPY (INITIAL): PINK OWNER COPY (INITIAL): GOLD