REDELL COUNTY HEALTH DEPARTMENT

STATESVILLE 704-878-5305 MOORESVILLE 704-664-5281

IMPROVEMENT PERMIT / AUTHORIZATION TO CONSTRUCT / OPERATION PERMIT / EXISTING SYSTEM INSPECTION

PERMIT # 159985 PIN # 4730711496 DATE 3/4/10

OWNER or APPLICANT Louis Melvin PHONE: Business (Cell) Home: Bob Melvin (336) 354-2428

OWNER or APPLICANT ADDRESS 148 Shady Cove rd

LOCATION / DIRECTIONS Perth to Shady Cove, lot on R 1/4 mile

SUBDIVISION Shady Cove BLOCK / SECTION LOT # 15 LOT AREA .5 Acres DESIGN FLOW existing L.T.A.R. existing

Septic Tank existing Gallons: STB existing Date existing

Pump Tank N/A Gallons: P T Date

Pump Make Model Serial #

Nitrification Field No Fields 1 No Lines 3 Linear Feet 240 existing

Trench Width existing Max. Trench Bottom Depth existing Gravel Depth existing ☑ GRAVITY ☐ PRESSURE

☐ New System ☐ Repair ☐ Expansion System Type I II III IV V VI

System Description: existing gravity gravel

Repair System Description: 15A NCAC 18A .1951

Maintenance Agreement Required ☐ YES ☑ NO

☑ Residence No. Bedrooms 3 ☐ Business No. Persons ☐ Other No. Employees ☐ Slab ☐ Crawl Space ☑ Basement w/plumbing ☐ Basement w/o plumbing

Water Supply: ☑ Private ☐ Public ☐ Community

Comments / Conditions


SCALE - 1" = 50'

*EXISTING SEPTIC SYSTEM APPEARED TO BE FUNCTIONING PROPERLY AT TIME OF EXISTING SYSTEM INSPECTION


Comments / Conditions *DO NOT USE PARKING AREA INDICATED AS (P) FOR VEHICLE TRAFFIC TO AVOID FUTURE SEPTIC PROBLEMS

* GARAGE ADDITION NOT APPROVED FOR PLUMBING OR ADD. OF AN EXTRA BEDROOM

INITIAL SITE SKETCH

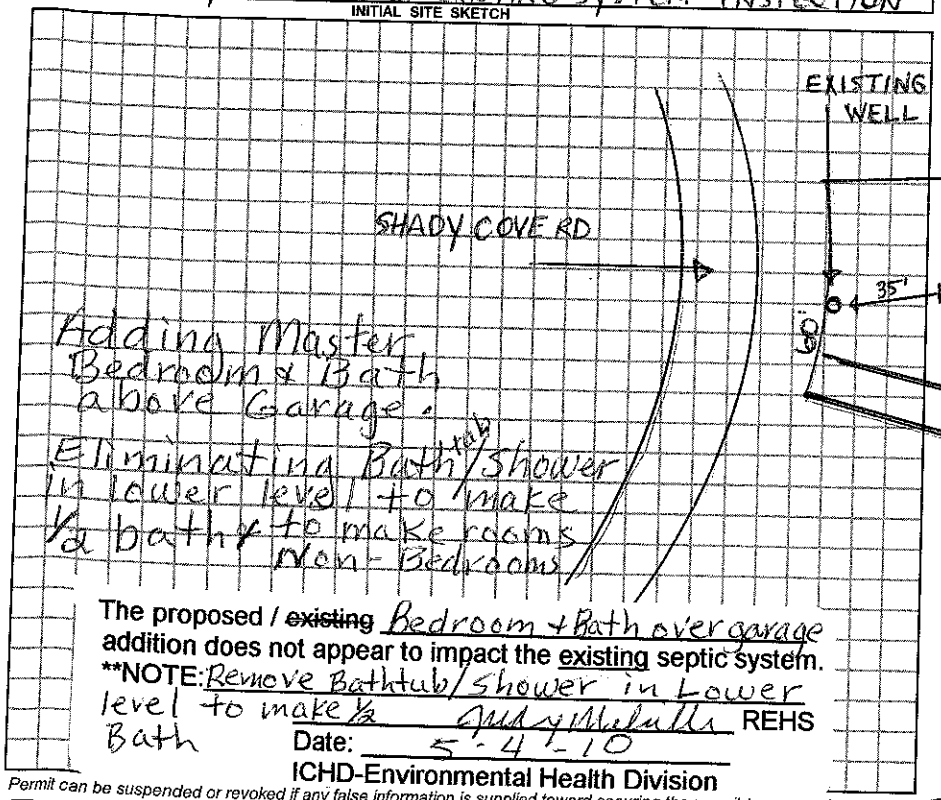

AS BUILT SKETCH

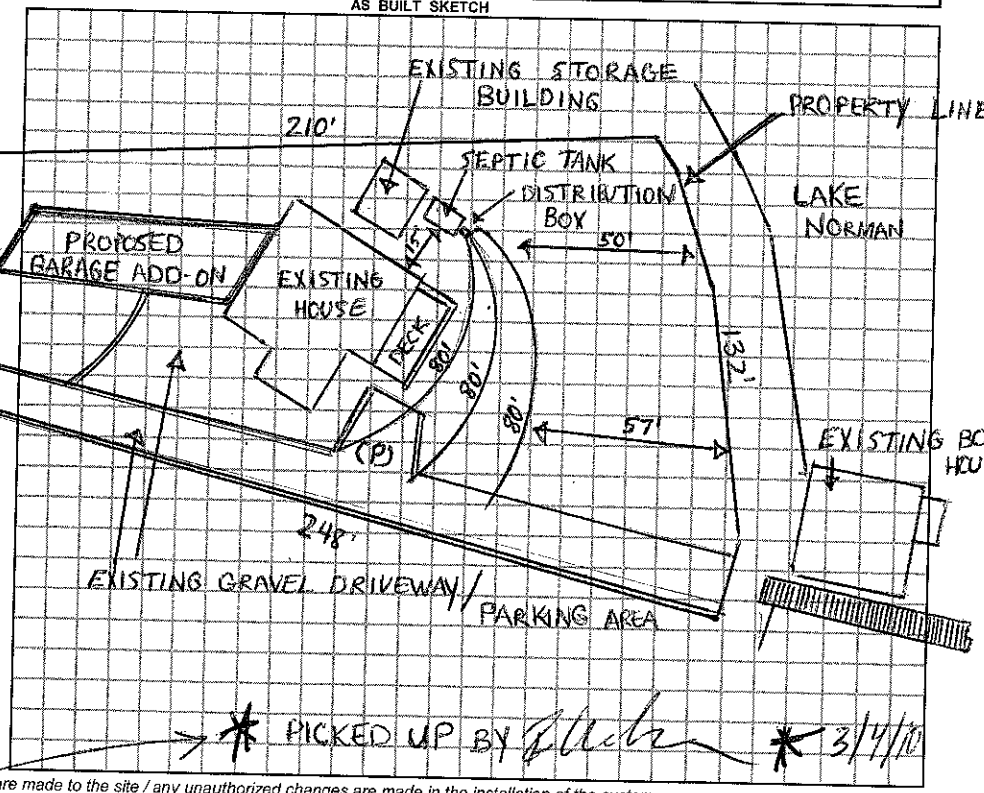

The proposed / ~~existing~~ Bedroom + Bath over garage addition does not appear to impact the existing septic system.

**NOTE: Remove Bathtub/Shower in Lower level to make ½ Bath

Judy Melvin

REHS

Date: 5-4-10

ICHD-Environmental Health Division

* PICKED UP BY [illegible] * 3/4/10

Permit can be suspended or revoked if any false information is supplied toward securing the permit / any unauthorized changes are made to the site / any unauthorized changes are made in the installation of the system.

☐ *IMPROVEMENT PERMIT w / plat valid without expiration.* ☐ *IMPROVEMENT PERMIT w / site plan valid for 60 mos.* ☐ *AUTHORIZATION TO CONSTRUCT valid for period equal to IMPROVEMENT PERMIT-not to exceed 60 mo.*

Owner / Applicant Signature: _____ Date _____

Improvement Permit by: _____ Date _____

Authorization to Construct by: _____ Date _____

YOU SHOULD CONTACT A LOCATOR SERVICE PRIOR TO ANY EXCAVATION.

Installed by: _____

Operation Permit by: _____ Date: _____

Existing System Inspected by: Kyle Ballin, REHS Date: 3/4/10

WHITE COPY Environmental Health YELLOW COPY (Final) Owner / Applicant PINK COPY (Initial) Owner / Applicant