Application to Construct

IREDELL COUNTY HEALTH DEPARTMENT

STATESVILLE 704-878-5305 MOORESVILLE 704-664-5281

IMPROVEMENT PERMIT / GERTIFICATE OF COMPLETION / OPERATION PERMIT / EXISTING SYSTEM INSPECTION

Watershed: ☑ Yes ☐ No

PROPERTY DESCRIPTION NO. 17510 DATE 12/1/93 TAX MAP NO. 3F 9A 22 4730 71 7330

OWNER OR CONTRACTOR ~~HOPE BROTHERS BUILDERS~~ (RICK SARTAIN) PHONE: Business ~~872-4111~~ Home 528-6004

ADDRESS 1120 BARKLEY RD. STATESVILLE, NC 28677

LOCATION SHADY COVE RD. : 2 MI E ON (R) SITE CLASS. P DESIGN FLOW 360 L.T.A.R. .25-.3

SUBDIVISION SHADY COVE BLOCK / SECTION 2 LOT 22 LOT AREA ~.757

Septic Tank: 1000 Gallons; STB 794 Date 11/20/96

Pump Tank: 1000 Gallons; PT 27 Date 11/20/96

Pump Make: HYDROMATIC Model 51-A Serial No.

Nitrification Field: No Fields 1 Square Feet 1200 Linear Feet 400

No Lines 5 Trench Width 3' Max Trench Bottom Depth 3'

☑ New System ☐ Repair System Type: I, II, (III) IV, V, VI

System Description: PUMP-TO CONVENTIONAL

Repair System Description:

Maintenance Agreement Required: ☑ Yes ☐ No 5 YR.

☑ House/Mod. Home No. Bedrooms 3

☐ Mobile Home No. Bathrooms 2

☐ Business No. Employees

☐ Other


Water Supply: ☑ Individual ☐ Community ☐ Public

Gravel Depth 12" ☐ Slab ☑ Crawl Space ☐ Basement w/plumbing ☐ Basement wo/plumbing

Comments: Trenches no deeper than 36" to trench bottom
Lines on slope contour in direction shown.

Comments: 1/17/97 - Uncompleted appointment - 3:30pm
1/21/97 - Electrical pending
Installed as shown.

INITIAL SITE SKETCH

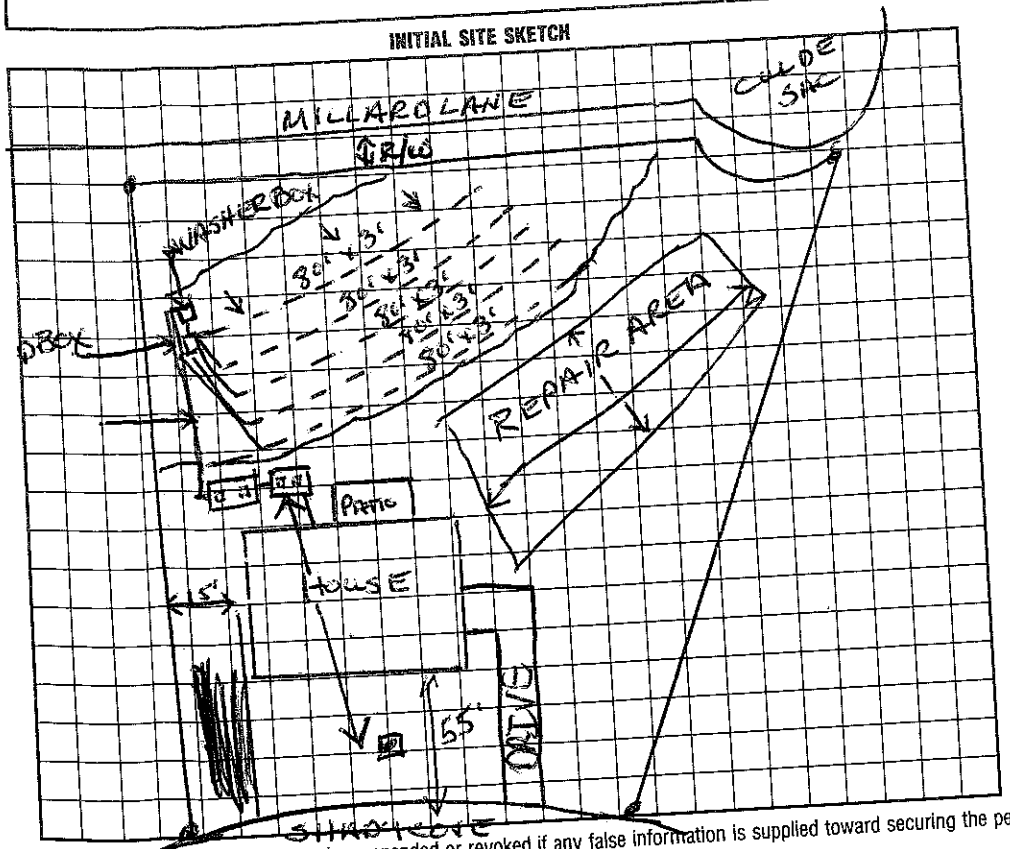

AS BUILT SKETCH

I understand that this permit can be suspended or revoked if any false information is supplied toward securing the permit/any unauthorized changes are made to the site/any unauthorized changes are made in the installation of the system. Improvement Permit is valid for 60 months from date of issuance.

Installed by: Tim Ammons

Signed: + John Hz Certificate of Completion by: Wesley Sparks RS date 3/24/97

Improvement Permit by: Wesley Sparks RS. date 12/1/93 Operation Permit by: Wesley Sparks RS date 3/24/97

Authorization to Existing System Inspection by: C. Brady Barnes EHS date 6/6/96

INSPECTION COPY (FINAL): GREEN OWNER COPY (FINAL): YELLOW INSPECTION COPY (INITIAL): PINK OWNER COPY (INITIAL): GOLD

Valid for 60 months from issue date.