IREDELL COUNTY HEALTH DEPARTMENT

STATESVILLE 704-878-5305 MOORESVILLE 704-664-5281

IMPROVEMENT PERMIT / AUTHORIZATION TO CONSTRUCT / OPERATION PERMIT / EXISTING SYSTEM INSPECTION

PERMIT# 071268 PIN# 4730718274 DATE 1-21-98

OWNER OR CONTRACTOR Hope Brothers PHONE: Business (704) 872-4111 Home

ADDRESS 1120 Barkley Rd Statesville, NC 28677

LOCATION Perth Rd N.J TR Shady Cove TL Millard at end in Cul-de-Sac

SUBDIVISION Shady Cove BLOCK / SECTION 2J LOT 16 LOT AREA SITE CLASS. PS DESIGN FLOW 360gpd L.T.A.R. .3+

Septic Tank: 1000 Gallons; STB 1012 Date 1/13/98
Pump Tank: Gallons; PT Date
Pump Make: Model Serial No.
Nitrification Field: No Fields 1 Square Feet 900' Linear Feet 300'
No Lines 3 at 100' Trench Width 36" Max Trench Bottom Depth 30-36" Gravel Depth N/A

[X] New System [ ] Repair System Type: I, II, (III), IV, V, VI
System Description: Gravity Chamber w/ Sump
Repair System Description Gravity/Pump Chamber w/ Sump
Maintenance Agreement Required: [ ] Yes [ ] No

[X] House/Mod. Home No. Bedrooms 3
[ ] Mobile Home No. Bathrooms 2
[ ] Business No. Employees
[ ] Other


[ ] Slab [X] Crawl Space [ ] Basement w/plumbing [X] Basement wo/plumbing

Water Supply: [X] Individual [ ] Public [ ] Community


Comments:/Conditions: Keep at least 50' Separation distance between Septic Systems & Well(s). Surface waters & runoff of surface water must be diverted away from Drainfield.

Comments:/Conditions:

INITIAL SITE SKETCH Scale 1:50

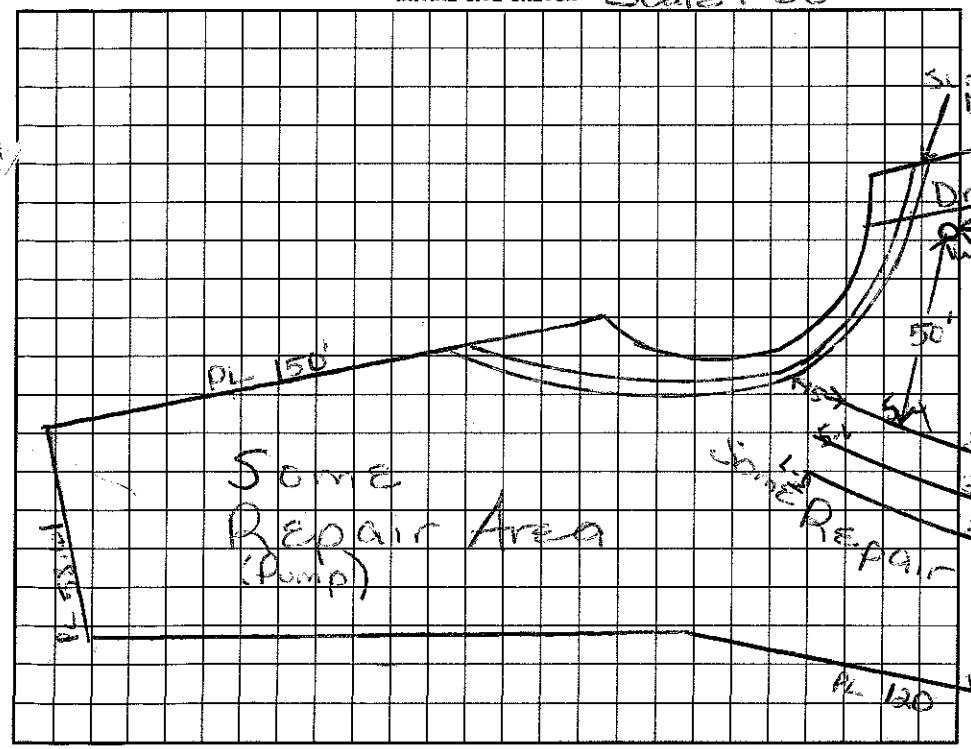

AS BUILT SKETCH

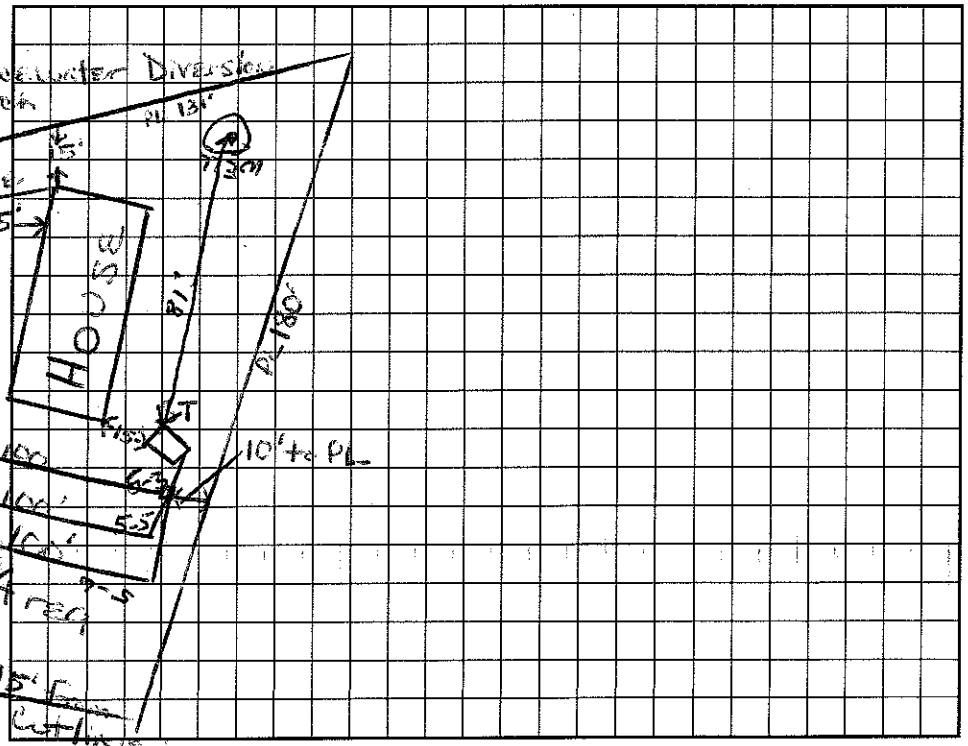

I understand that this permit can be suspended or revoked if any false information is supplied toward securing the permit/any unauthorized changes are made to the site/any unauthorized changes are made in the installation of the system. Improvement Permit with plat valid without expiration. Improvement Permit with site plan valid for sixty months. Authorization to Construct is valid for a period equal to that of Improvement Permit – not to exceed sixty months.

Signed: Judy L Hogan date 2-5-98 Installed by: Ronnie Duncan

Improvement Permit by: Maria H H Dotson date 1/23/98 Operation Permit by: Wesley Sparks RS date 8/12/98

Authorization to Construct by: Maria H H Dotson date 1/23/98 Existing System Inspection by: date

HEALTH DEPT. COPY: WHITE INSPECTION COPY (FINAL): GREEN OWNER COPY (FINAL): YELLOW INSPECTION COPY (INITIAL): PINK OWNER COPY (INITIAL): GOLD