(10.00)

# IREDELL COUNTY HEALTH DEPARTMENT

STATESVILLE 704-878-5305 MOORESVILLE 704-664-5281

## IMPROVEMENT PERMIT / AUTHORIZATION TO CONSTRUCT / OPERATION PERMIT / EXISTING SYSTEM INSPECTION

PERMIT# 07419 PIN# 4730 719525 DATE 6/5/98

OWNER OR CONTRACTOR HOPE BROTHERS PHONE: Business Home 872-4114

ADDRESS 120 BARKLEY RD STATESVILLE NC 28677

LOCATION PERTH RD - TL SHADY COVE - TL MILLARD LN 2nd ON LT

SUBDIVISION SHADY COVE BLOCK / SECTION LOT 42 LOT AREA 131'X154' SITE CLASS. B5 DESIGN FLOW 360 GPD L.T.A.R. .36 GPD/FT

Septic Tank: 1000 Gallons; STB 1012 Date 4-23-98

Pump Tank: Gallons; PT Date

Pump Make: Model Serial No.

Nitrification Field: No Fields 1 Square Feet 780 Linear Feet 260

No Lines 4 Trench Width 36" Max Trench Bottom Depth 36" Gravel Depth NA

☑ New System ☐ Repair System Type: I, II, (III), IV, V, VI

System Description: GRAVITY CHAMBERS OR HDS

Repair System Description: GRAVITY PANEL

Maintenance Agreement Required: ☐ Yes ☑ No

☑ House/Mod. Home No. Bedrooms 3

☐ Mobile Home No. Bathrooms 2

☐ Business No. Employees

☐ Other


☐ Slab ☑ Crawl Space ☑ Basement w/plumbing ☐ Basement wo/plumbing

Water Supply: ☑ Individual ☐ Public ☐ Community

Comments:/Conditions:

Comments:/Conditions:

**INITIAL SITE SKETCH** 1"=50'

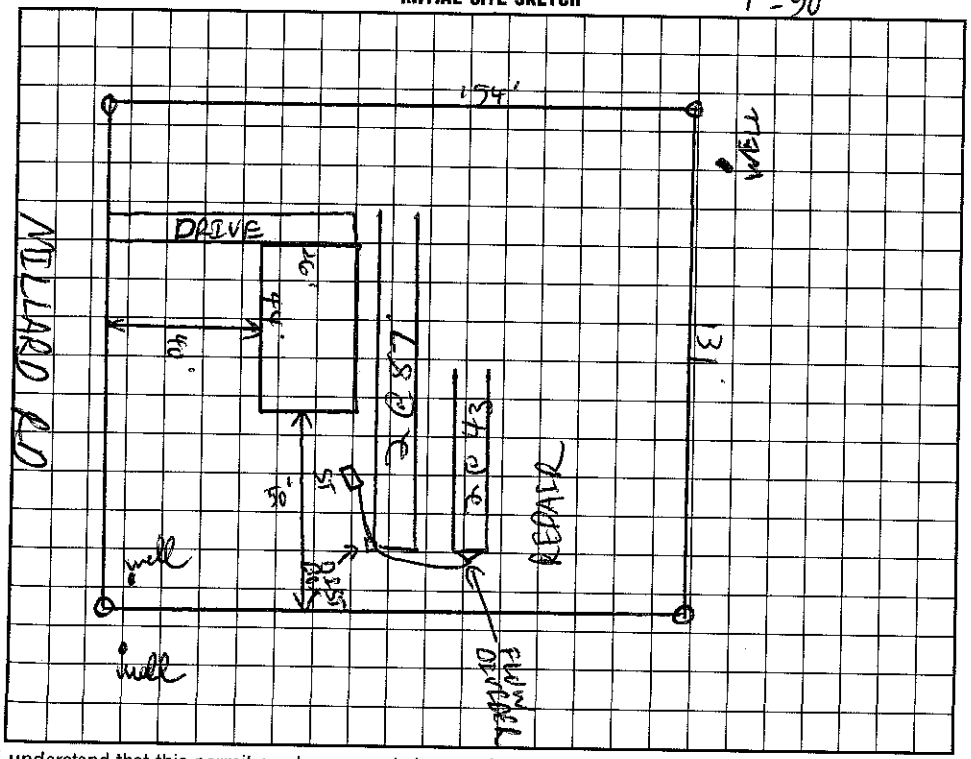


**AS BUILT SKETCH**

I understand that this permit can be suspended or revoked if any false information is supplied toward securing the permit/any unauthorized changes are made to the site/any unauthorized changes are made in the installation of the system. Improvement Permit with plat valid without expiration. Improvement Permit with site plan valid for sixty months. Authorization to Construct is valid for a period equal to that of Improvement Permit – not to exceed sixty months.

Signed: Jeff L Hope date 6-1-98 Installed by: Hope Brothers Build

Improvement Permit by: C. Ray Lewis RS date 6/5/98 Operation Permit by: Jeff Mayo date 6-9-98

Authorization to Construct by: C. Ray Lewis RS date 6/5/98 Existing System Inspection by: date

HEALTH DEPT. COPY: WHITE INSPECTION COPY (FINAL): GREEN OWNER COPY (FINAL): YELLOW INSPECTION COPY (INITIAL): PINK OWNER COPY (INITIAL): GOLD