IREDELL COUNTY HEALTH DEPARTMENT

STATESVILLE 704-878-5305 MOORESVILLE 704-664-5281

IMPROVEMENT PERMIT / AUTHORIZATION TO CONSTRUCT / OPERATION PERMIT / EXISTING SYSTEM INSPECTION

PERMIT# 109742 PIN# 4730729894 DATE 10/31/02

OWNER OR CONTRACTOR SKIPPERS DRY STORAGE PHONE: Business 201-0894 Home

ADDRESS 16315-B NORTHCROSS DR. HUNTERSVILLE NC 28078

LOCATION PERTH RD (N) - ON LT AFTER CROSSING LAKE AFTER SHADY COVE

SUBDIVISION BLOCK / SECTION LOT LOT AREA 6.26AC SITE CLASS. PS DESIGN FLOW 1500 GPD L.T.A.R. EXISTING

Septic Tank: EXISTING 3000 Gallons; STB 7 Date 10-6-03

Pump Tank: EXISTING 1000 Gallons; PT 7 Date 6-9-03

Pump Make: Model Serial No.

Nitrification Field: No Fields 1 Square Feet 3750 Linear Feet 1250

No Lines 10@125' Trench Width EXISTING Max Trench Bottom Depth EXISTING Gravel Depth

☑ New System ☐ Repair System Type: I, II, (III), IV, V, VI

System Description: EXISTING PUMP CONVENTIONAL

Repair System Description:

Maintenance Agreement Required: ☐ Yes ☐ No

☐ House/Mod. Home No. Bedrooms

☑ Mobile Home No. Bathrooms

☑ Business No. Employees

☑ Other 12 NEW WET SLIPS/4 DRY

☑ Slab ☐ Crawl Space ☐ Basement w/plumbing ☐ Basement wo/plumbing


Water Supply: ☑ Individual ☐ Public ☐ Community

Comments:/Conditions:


Comments:/Conditions: 1) SEE ADDENDUM FOR COMMENTS
2) EXISTING TANKS NOT TO BE DRIVEN OVER
3) FENCING TO BE PUT AROUND TANKS

1"=60'

INITIAL SITE SKETCH

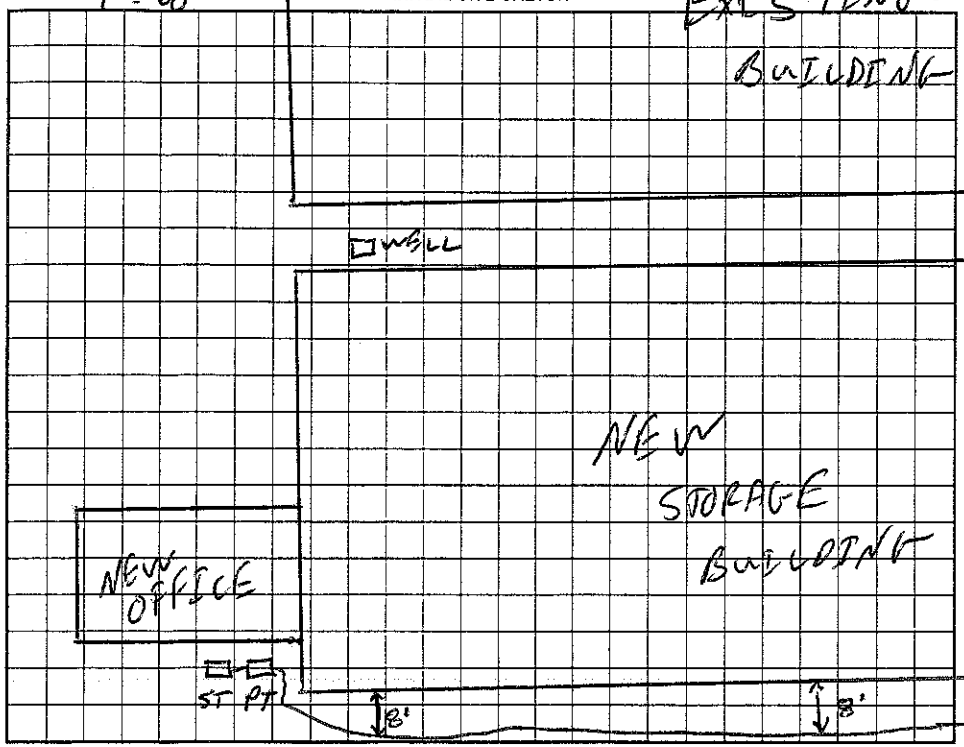

AS BUILT SKETCH

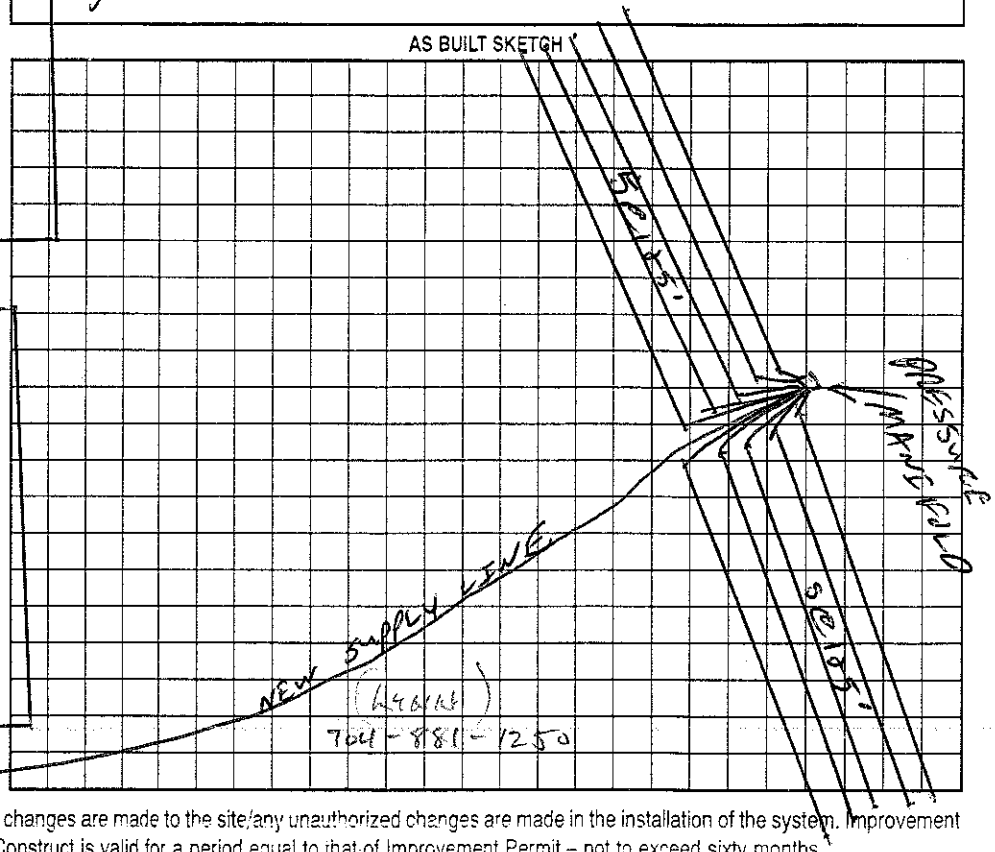

Permit can be suspended or revoked if any false information is supplied toward securing the permit/any unauthorized changes are made to the site/any unauthorized changes are made in the installation of the system. Improvement Permit with plat valid without expiration. Improvement Permit with site plan valid for sixty months. Authorization to Construct is valid for a period equal to that of Improvement Permit – not to exceed sixty months.

Signed: date 11-4-02 Installed by: CURT DUNNAGAN

Improvement Permit by: VES date 10/31/02 Operation Permit by: date 5/5/04

Authorization to Construct by: VES date 10/31/02 Existing System Inspection by: date

HEALTH DEPT. COPY: WHITE OWNER COPY (FINAL): YELLOW OWNER COPY (INITIAL): PINK