IREDELL COUNTY HEALTH DEPARTMENT

STATESVILLE 704-878-5305 MOORESVILLE 704-664-5281

IMPROVEMENT PERMIT / AUTHORIZATION TO CONSTRUCT / OPERATION PERMIT / EXISTING SYSTEM INSPECTION

PERMIT# ~~02-P-01-04/20388~~ PIN# 4730 ~~780073~~ -77-1842 DATE 3-1-04

OWNER OR CONTRACTOR KENNETH MILLSAPS PHONE: Business 704-902-2872 Home

ADDRESS 264 SPICEWOOD CIRCLE TROUTMAN, NC 28166

LOCATION 21 SOUTH (E) PERTH (L) SPICEWOOD (R) 1ST PAVED RD (L) AFTER BOX # 264

SUBDIVISION SPICEWOOD BLOCK / SECTION LOT 54 LOT AREA .43 AC SITE CLASS. PS DESIGN FLOW 360 L.T.A.R. .3

Septic Tank: 1000 Gallons; STB 55 Date 7-31-04
Pump Tank: Gallons; PT Date
Pump Make: Model Serial No.
Nitrification Field: No Fields 1 Square Feet EQ=1700' Linear Feet 200'
No Lines 4x50' Trench Width 24" Max Trench Bottom Depth 36" Gravel Depth N/A

☒ New System ☐ Repair System Type: I, II, (III) IV, V, VI
System Description: 6BAV 50% REDUCT
Repair System Description: LP 50% REDUCT
Maintenance Agreement Required: ☐ Yes ☒ No

☒ House/Mod. Home No. Bedrooms 3
☐ Mobile Home No. Bathrooms 2
☐ Business No. Employees
☐ Other
☐ Slab ☒ Crawl Space ☐ Basement w/plumbing ☐ Basement wo/plumbing


Water Supply: ☐ Individual ☒ Public ☐ Community

Comments:/Conditions: (1) INSTALL 4 LINES X 50' LONG ON CONTOUR AS DRAWN (2) INSTALL LINES ON CONTOURS & MAINTAIN SETBACKS (3) USE A FLOW EQUALIZATION DEVICE SUCH AS THE ZOELLER TRU FLOW SPLITTER TO ACHIEVE EQUAL DISTRIBUTION.

Comments:/Conditions: POLYLOK FILTER & MANIFOLD

USED 3 FLOW DIVIDER TEE'S INSTEAD OF BOX

INITIAL SITE SKETCH 1"≈50'

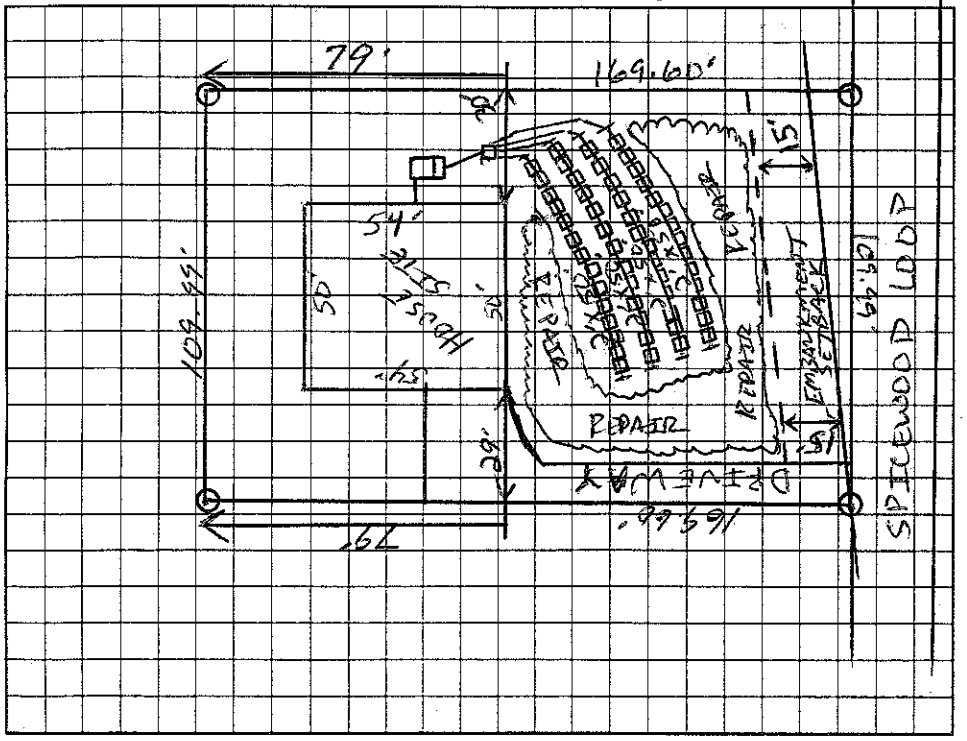

AS BUILT SKETCH BOX

Permit can be suspended or revoked if any false information is supplied toward securing the permit/any unauthorized changes are made to the site/any unauthorized changes are made in the installation of the system. Improvement Permit with plat valid without expiration. Improvement Permit with site plan valid for sixty months. Authorization to Construct is valid for a period equal to that of Improvement Permit – not to exceed sixty months.

Signed: date 3-2-04
Improvement Permit by: date 3-1-04
Authorization to Construct by: date 4-27-04

Installed by: G & M ENTERPRISES
Operation Permit by: date 10-26-04
Existing System Inspection by: date

HEALTH DEPT. COPY: WHITE OWNER COPY (FINAL): YELLOW OWNER COPY (INITIAL): PINK