IREDELL COUNTY HEALTH DEPARTMENT

STATESVILLE 704-878-5305 MOORESVILLE 704-664-5281

IMPROVEMENT PERMIT / AUTHORIZATION TO CONSTRUCT / OPERATION PERMIT / EXISTING SYSTEM INSPECTION

12854B PERMIT # CI

PERMIT# 03-P-01-04 PIN# 4730277~~1842~~ 1913 DATE 3-1-04

OWNER OR CONTRACTOR ~~KENNETH MILLSAPS~~ Douglas Murdock PHONE: Business 704 902-2872 Home

ADDRESS 264 SPICEWOOD CIRCLE TROUTMAN, NC 28166

LOCATION 21 SOUTH, (R) PERTH, (L) SPICEWOOD (R) 1ST RD, PROPERTY ON LEFT BY BOX # 264

SUBDIVISION SPICEWOOD BLOCK / SECTION LOT 52 LOT AREA .43 AC SITE CLASS. PS DESIGN FLOW 360 L.T.A.R. .3

Septic Tank: 1000 Gallons; STB 160 Date 6-24-05
Pump Tank: 1000 Gallons; PT 319 Date 6-27-05
Pump Make: ZOELLER Model N-137 Serial No. —
Nitrification Field: No Fields 1 Square Feet ERA 1200 Linear Feet 200'
No Lines 6x33' Trench Width 24" Max Trench Bottom Depth 36" Gravel Depth N/A

☒ New System ☐ Repair System Type: I, II, (III) IV, V, VI
System Description: PUMP / PRES. MANIFOLD / 50% RED
Repair System Description: LP 50% REDUCT
Maintenance Agreement Required: ☐ Yes ☒ No


☒ House/Mod. Home ☐ Mobile Home ☐ Business ☐ Other
No. Bedrooms 3 No. Bathrooms 2 No. Employees ___

☐ Slab ☒ Crawl Space ☐ Basement w/plumbing ☐ Basement wo/plumbing

Water Supply: ☐ Individual ☒ Public ☐ Community

Comments:/Conditions: (1) INSTALL 6 LINES x 33' LONG, FED BY A PRESSURE MANIFOLD AS DRAWN (2) INSTALL LINES ON CONTOURS & MAINTAIN SETBACKS (3) INITIAL & REPAIR WERE COMPLETELY FLAGGED IN. (3) EXISTING WELL TO BE ABANDONED ACCORDING TO ISA NCAC 2C .0100 & SUBMIT FORM GW-30. (4) POSITIVE DRAINAGE REQUIREMENTS MUST BE FILLED & NOT CUT. THIS CAN BE DONE BY KEEPING HOUSE OUT OF GROUND & BACKFILLING FOR POSITIVE DRAINAGE. SETBACK WILL THEN ONLY BE 15' AS DRAWN. IF CUT PERMIT WILL BE VOID. (5) CALL PRIOR TO INSTALLATION FOR PUMP SIZING & SPECS IF NECESSARY.

INITIAL SITE SKETCH 1" = 50'

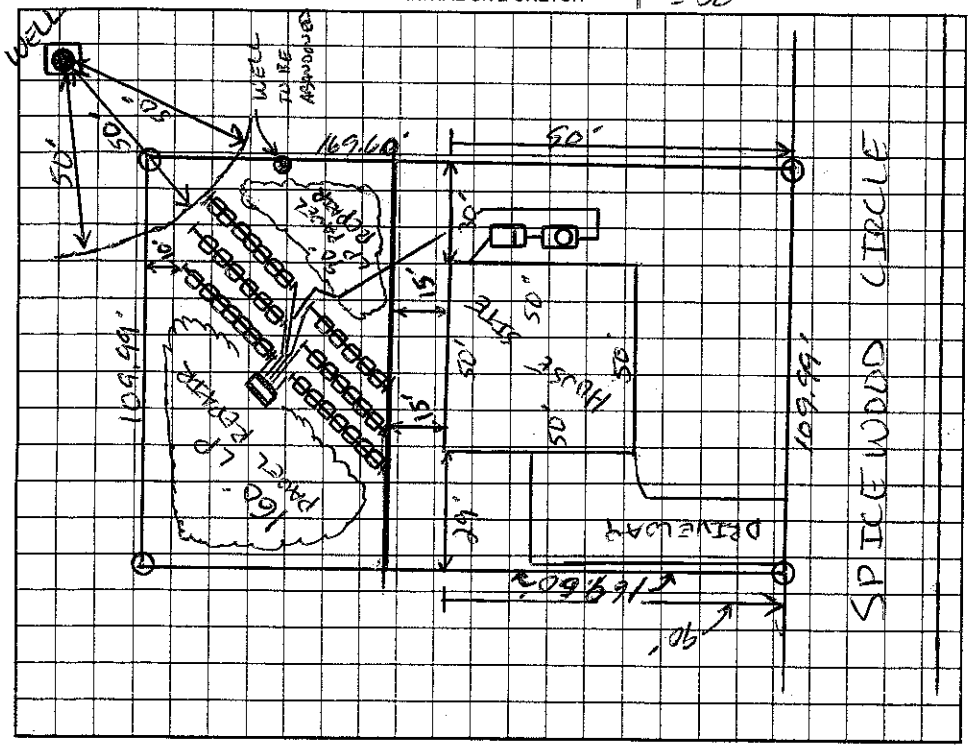

AS BUILT SKETCH

Released WELL ABANDONMENT & HOUSE PLANS ON 6-24-05
DONOT POUR DRIVEWAY UNTIL TANKS ARE SET TO VERIFY SETBACKS LC 6-24-05. TANKS WILL HAVE TO MOVE IF BUILDER Approved 64x34' HOUSE PLAN OK'D CHANGES LC 7-06 JM
ASBUILT FILE & MARKER

BUILDER OK'S TANK CHANGES.
* Doug L Murdock

* VID LINES & TANKS 10-20-05 LC
SETPRESSURE & ALL ELECTRICAL ON 2-7-06
* WEEDS FLOAT TREE MADE
11'0 FLOAT TREE 2-10-06 LC

Permit can be suspended or revoked if any false information is supplied toward securing the permit/any unauthorized changes are made to the site/any unauthorized changes are made in the installation of the system. Improvement Permit with plat valid without expiration. Improvement Permit with site plan valid for sixty months. Authorization to Construct is valid for a period equal to that of Improvement Permit -- not to exceed sixty months.

Signed: _____ date 3-2-04 Installed by: Shane JARRETT

Improvement Permit by: _____ date 3-1-04 Operation Permit by: _____ date 2-10-06

Authorization to Construct by: _____ date 6-24-05 Existing System Inspection by: _____ date _____

HEALTH DEPT. COPY: WHITE OWNER COPY (FINAL): YELLOW OWNER COPY (INITIAL): PINK