IREDELL COUNTY HEALTH DEPARTMENT

STATESVILLE 704-878-5305 MOORESVILLE 704-664-5281

IMPROVEMENT PERMIT / AUTHORIZATION TO CONSTRUCT / OPERATION PERMIT / EXISTING SYSTEM INSPECTION

PERMIT # Repair PIN # 4730-77-2999 DATE 23 November 09

OWNER or APPLICANT Carl Ashley PHONE: Business (704) 881-4080 Home:

OWNER or APPLICANT ADDRESS 109 Hebert Drive Statesville, N.C.

LOCATION / DIRECTIONS Perth Rd. from Hy 21 - TL Spicewood just past Perth Bait Tackle, TR Nutmeg - House on Rt.

SUBDIVISION 122 Nutmeg Lane Intn. BLOCK / SECTION LOT # 15 LOT AREA 0.52Ac. DESIGN FLOW 360 g/d L.T.A.R. 0.35 g/ft²/d


Septic Tank 1000	Gallons: STB 1007	Date 10-10-09	☐ New System ☑ Repair ☐ Expansion System Type I II (III) IV V VI
Pump Tank	Gallons: PT	Date	System Description: 25% Reduction
Pump Make	Model	Serial #	Repair System Description: 25% REDUCTION
Nitrification Field No Fields 1	No Lines 5	Linear Feet 300	Maintenance Agreement Required ☐ YES ☑ NO
Trench Width 36"	Max. Trench Bottom Depth 36"	Gravel Depth NA	☑ GRAVITY ☐ PRESSURE

☑ Residence No. Bedrooms 3	Water Supply
☐ Business No. Persons	☑ Private
☐ Other No. Employees	☐ Public
☐ Slab ☑ Crawl Space	☐ Community
☐ Basement w/plumbing ☐ Basement w/o plumbing	

Comments / Conditions: Replumb into new septic tank and drainfield in front yard. Keep 5' from house & prop. lines. End cap distribution will be allowed.

Comments / Conditions: Polylock tee installed. ST has marker

INITIAL SITE SKETCH

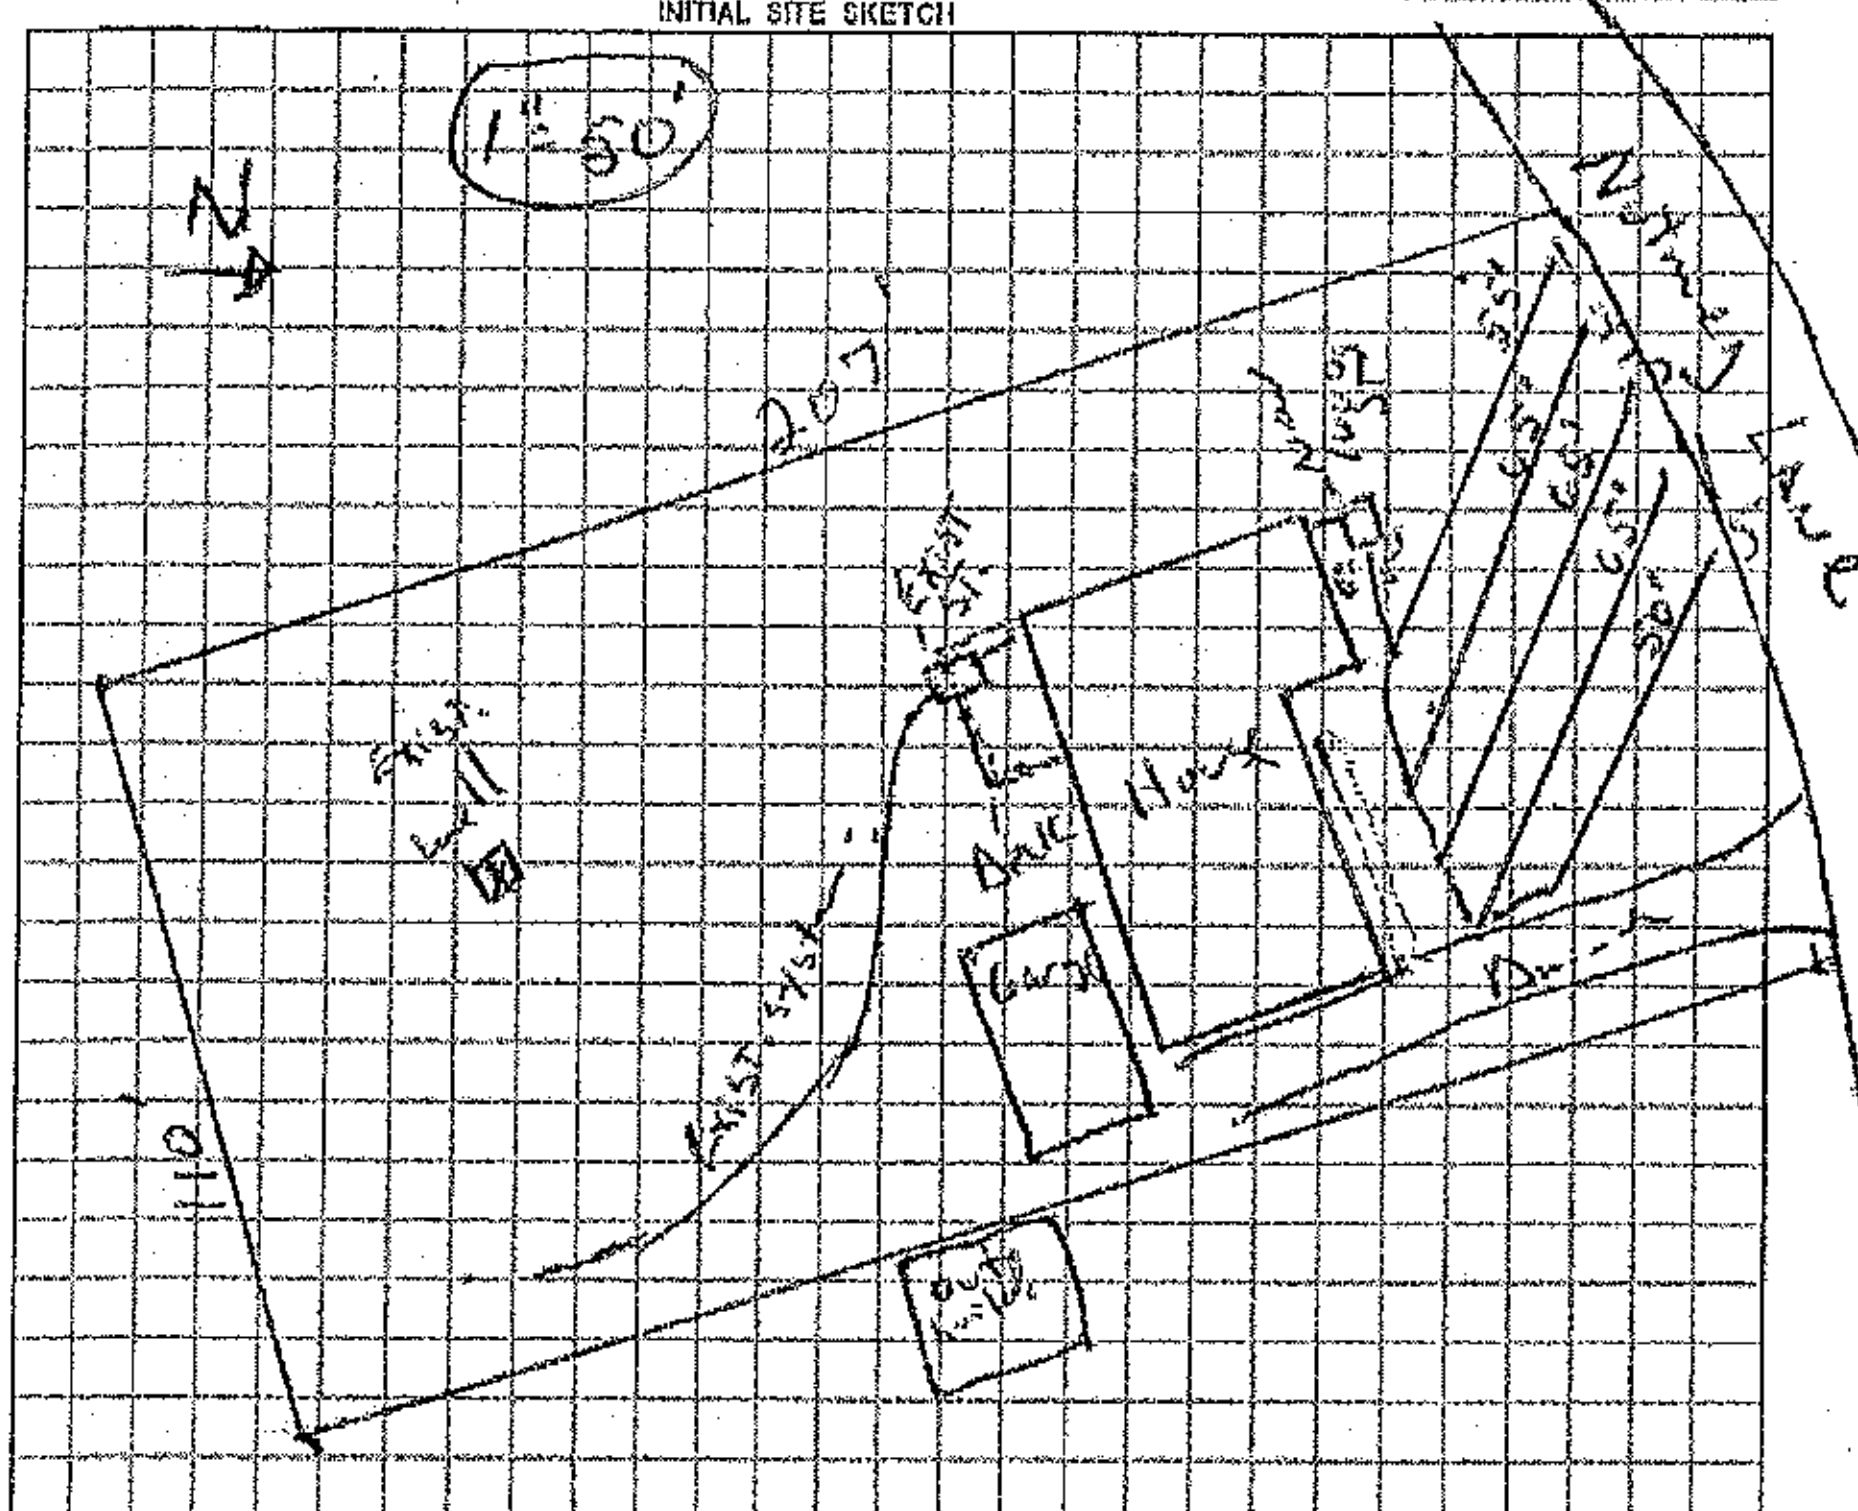

AS BUILT SKETCH

* End cap to end cap distribution

Line 1 - 50'
Line 2 - 55'
Line 3 - 60'
Line 4 - 55'
Line 5 - 50'

Permit can be suspended or revoked if any false information is supplied toward securing the permit / any unauthorized changes are made to the site / any unauthorized changes are made in the installation of the system.

☐ IMPROVEMENT PERMIT w / plat valid without expiration. ☐ IMPROVEMENT PERMIT w / site plan valid for 60 mos. ☑ AUTHORIZATION TO CONSTRUCT valid for period equal to IMPROVEMENT PERMIT-not to exceed 60 mo.

Owner / Applicant Signature: [signature] Date 11/24/09 Installed by: James Hudd(?) [signature]

Improvement Permit by: [signature], R.S. Date 23 Nov 09 Operation Permit by: [signature], R.S. Date: 11 Dec 09

Authorization to Construct by: [signature], R.S. Date 23 Nov 09 Existing System Inspected by: Date:

YOU SHOULD CONTACT A LOCATOR SERVICE PRIOR TO ANY EXCAVATION.

WHITE COPY Environmental Health YELLOW COPY (Final) Owner / Applicant PINK COPY (Initial) Owner / Applicant