IREDELL COUNTY HEALTH DEPARTMENT

STATESVILLE 704-878-5305 MOORESVILLE 704-664-5281

IMPROVEMENT PERMIT / AUTHORIZATION TO CONSTRUCT / OPERATION PERMIT / EXISTING SYSTEM INSPECTION

PERMIT # Repair PIN # 4730-77-2999 DATE 23 November 09

OWNER or APPLICANT Carl Ashley PHONE: Business (704) 881-4080 Home:

OWNER or APPLICANT ADDRESS 109 Heavenly Drive Statesville, N.C.

LOCATION / DIRECTIONS Ruth Rd. from Hy 21 - TL Spicewood just past Ruth Bait & Tackle, TR Nutmeg - House on Rt.

SUBDIVISION 122 Nutmeg Lane Extn. BLOCK / SECTION LOT # 15 LOT AREA 0.52ac. DESIGN FLOW 360 gpd L.T.A.R. 0.3/.574


Septic Tank	1000	Gallons: STB	1007	Date	10-10-09	☐ New System	☑ Repair	☐ Expansion System	Type I II ◐ IV V VI
Pump Tank		Gallons: PT		Date		System Description:	25% Reduction		
Pump Make		Model		Serial #		Repair System Description:	25% REDUCTION		
Nitrification Field	No Fields 1	No Lines 5	Linear Feet 300			Maintenance Agreement Required	☐ YES	☑ NO	
Trench Width	36"	Max. Trench Bottom Depth	36"	Gravel Depth	NA	☑ GRAVITY	☐ PRESSURE		

☑ Residence	No. Bedrooms 3	Water Supply	
☐ Business	No. Persons	☑ Private	
☐ Other	No. Employees	☐ Public	
☐ Slab	☑ Crawl Space	☐ Community	
☐ Basement w/plumbing	☐ Basement w/o plumbing		


Comments / Conditions: Replumb into new septic TANK and drainfield in front yard. Keep 5' from house & Prop. lines. End cap distribution will be allowed.

Comments / Conditions: Polylock Tee installed. ST has MARKER

INITIAL SITE SKETCH

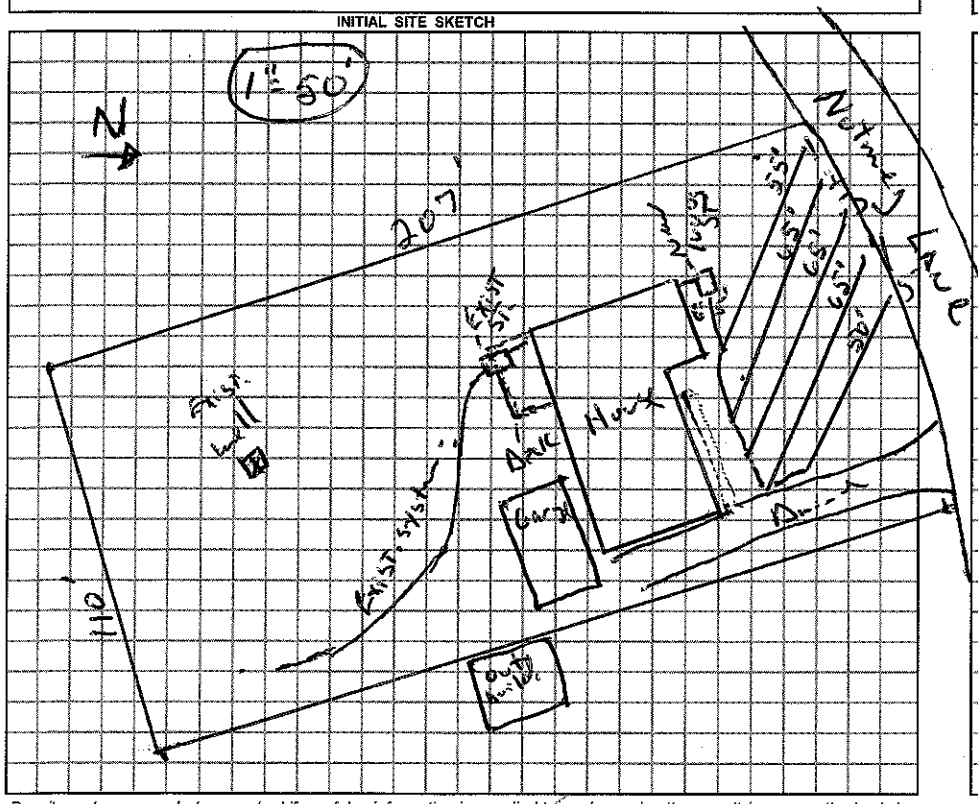

AS BUILT SKETCH

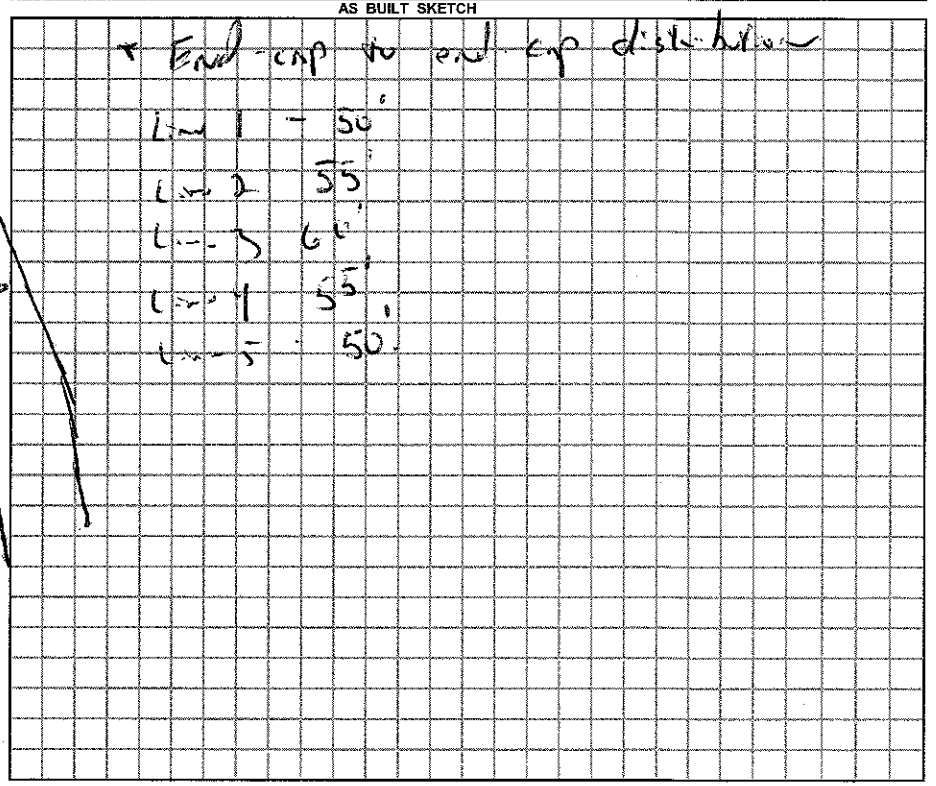

Permit can be suspended or revoked if any false information is supplied toward securing the permit / any unauthorized changes are made to the site / any unauthorized changes are made in the installation of the system.

☐ *IMPROVEMENT PERMIT w / plat valid without expiration.* ☐ *IMPROVEMENT PERMIT w / site plan valid for 60 mos.* ☑ *AUTHORIZATION TO CONSTRUCT valid for period equal to IMPROVEMENT PERMIT-not to exceed 60 mo.*

Owner / Applicant Signature: Date 11/24/09 Installed by: James Hulder

Improvement Permit by: , R.S. Date 23 Nov 09 Operation Permit by: , R.S. Date: 11 Dec. 09

Authorization to Construct by: , R.S. Date 23 Nov. 09 Existing System Inspected by: Date:

YOU SHOULD CONTACT A LOCATOR SERVICE PRIOR TO ANY EXCAVATION.

WHITE COPY Environmental Health YELLOW COPY (Final) Owner / Applicant PINK COPY (Initial) Owner / Applicant