11:00-12:00

THIS PERMIT REPLACES PERMIT ISSUED 11-17-05

IREDELL COUNTY HEALTH DEPARTMENT

STATESVILLE 704-878-5305 (a) MOORESVILLE 704-664-5281

IMPROVEMENT PERMIT / AUTHORIZATION TO CONSTRUCT / OPERATION PERMIT / EXISTING SYSTEM INSPECTION

PERMIT# (TROUTMAN) 149295 PIN# 4730773881 DATE 3-17-08

OWNER OR APPLICANT Summerwood Homes LLC PHONE: Business 704-799-8085 Home

ADDRESS 132 Nutmeg Lane Troutman

LOCATION Troutman, - South on Perth, left on Spicewood, (R) on Nutmeg Ln - lot at end.

SUBDIVISION Spicewood BLOCK / SECTION LOT 24 LOT AREA SITE CLASS. PS DESIGN FLOW 360 L.T.A.R. .3

Septic Tank: 1000 Gallons: STB 1012 Date 10-21-07

Pump Tank: Gallons; PT Date

Pump Make: Model Serial No.

Nitrification Field: No Fields 1 Square Feet 1200 Linear Feet 300

No Lines 3 Trench Width 36" Max Trench Bottom Depth 36" Gravel Depth n/a

☑ New System ☐ Repair ☐ Expansion System Type: I (II) III IV V VI

System Description: 25% Reduction - Gravity

Repair System Description: 50% Reduction - LP

Maintenance Agreement Required: ☐ Yes ☑ No

☑ Gravity ☐ Pressure

☑ House/Mod. Home No. Bedrooms 3

☐ Mobile Home No. Persons

☐ Business No. Employees

☐ Other


Water Supply: ☐ Individual ☐ Public ☐ Community

☐ Slab ☑ Crawl Space ☐ Basement w/plumbing ☐ Basement wo/plumbing

Comments:/Conditions:

Comments:/Conditions:

INITIAL SITE SKETCH

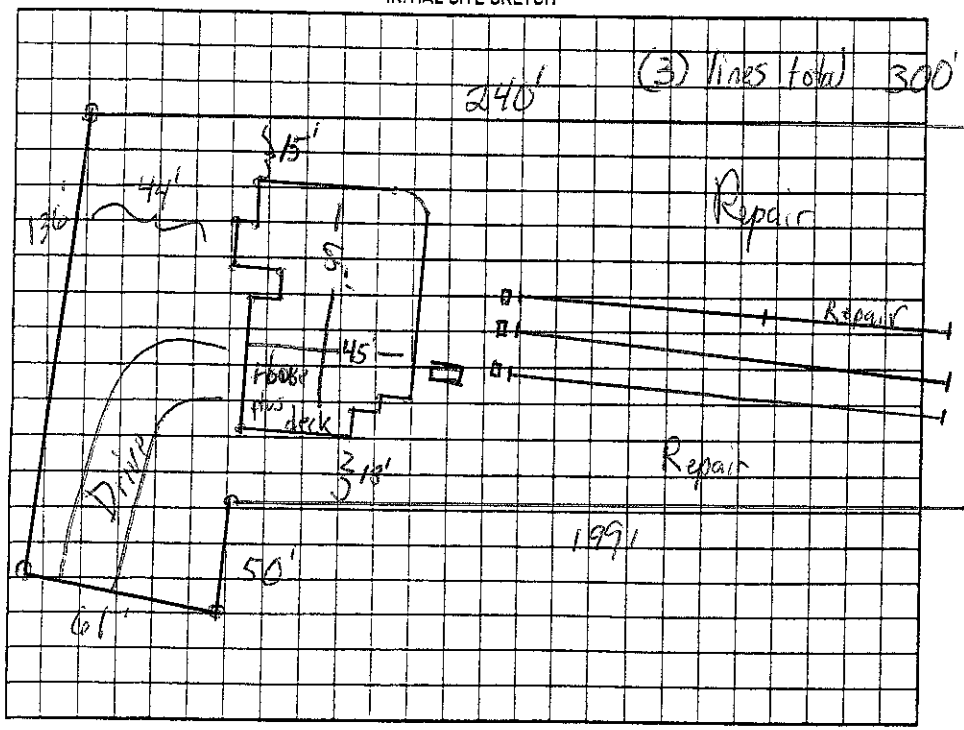

AS BUILT SKETCH

Permit can be suspended or revoked if any false information is supplied toward securing the permit/any unauthorized changes are made to the site/any unauthorized changes are made in the installation of the system. Improvement Permit with plat valid without expiration ☐ Improvement Permit with site plan valid for sixty months ☑ Authorization to Construct is valid for a period equal to that of Improvement Permit – not to exceed sixty months.

Signed: Barbara Braun date 3-17-08 Installed by: Steve Jordan

Improvement Permit by: date 3-17-08 Operation Permit by: date 9-2-08

Authorization to Construct by: date 3-17-08 Existing System Inspection by: date

HEALTH DEPT. COPY: WHITE OWNER COPY (FINAL): YELLOW OWNER COPY (INITIAL): PINK