91479

IREDELL COUNTY HEALTH DEPARTMENT

STATESVILLE 704-878-5305 MOORESVILLE 704-664-5281

300 ok

IMPROVEMENT PERMIT / AUTHORIZATION TO CONSTRUCT / OPERATION PERMIT / EXISTING SYSTEM INSPECTION

PERMIT# -2- TROUTMAN PIN# 3114-C-3 DATE 11/9/99

OWNER OR CONTRACTOR LARRY DAVIS PHONE: Business Home

ADDRESS 450 OAK TREE RD MOORESVILLE 28117

LOCATION RICHARD (S)- TL SYCAMORE - ON RT

SUBDIVISION SYCAMORE BLOCK / SECTION LOT 19 LOT AREA .718 AC SITE CLASS PS DESIGN FLOW 360 GPD L.T.A.R. .3 gal/ft²

Septic Tank: 1000 Gallons: STB 1012 Date 8-27-00
Pump Tank: Gallons: PT Date
Pump Make: Model Serial No.
Nitrification Field: No Fields 1 Square Feet 900 Linear Feet 300
No Lines 6 @ 50' Trench Width 36" Max Trench Bottom Depth 36" Gravel Depth N/A

☑ New System ☐ Repair System Type: I, II, III, IV, V, VI
System Description: GRAVITY 25% REDUCTION PANEL
Repair System Description: PANEL
Maintenance Agreement Required: ☐ Yes ☑ No


☑ House/Mod. Home No. Bedrooms 3
☐ Mobile Home No. Bathrooms 2
☐ Business No. Employees
☐ Other
☐ Slab ☑ Crawl Space ☐ Basement w/plumbing ☐ Basement wo/plumbing

Water Supply: ☐ Individual ☑ Public ☐ Community TROUTMAN


Comments/Conditions:

Comments/Conditions
First 3 Lines check
Infiltrators installed Polylok filter

INITIAL SITE SKETCH

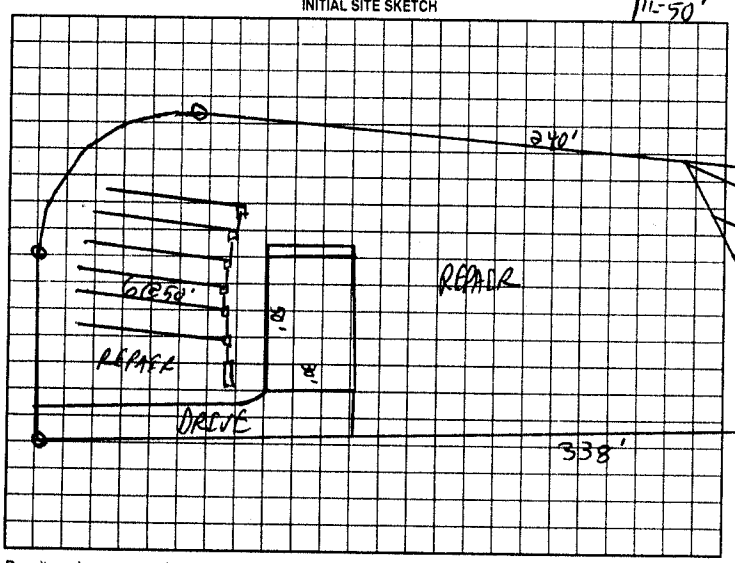

AS BUILT SKETCH

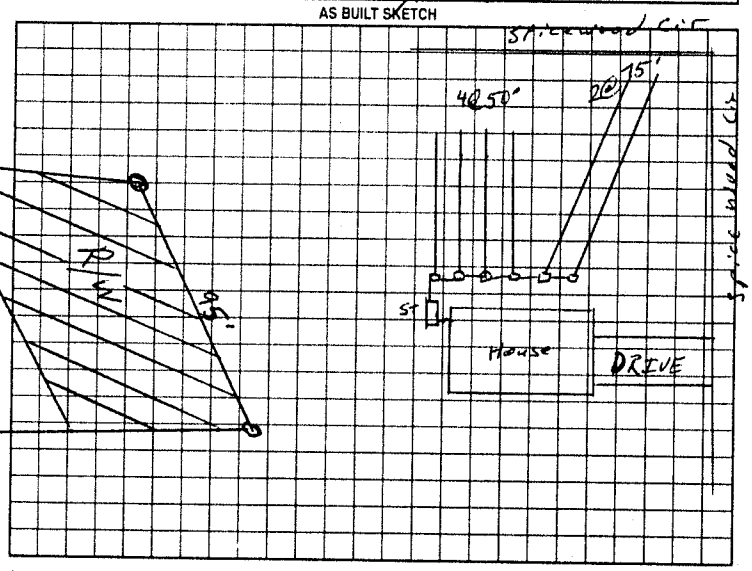

Permit can be suspended or revoked if any false information is supplied toward securing the permit/any unauthorized changes are made to the site/any unauthorized changes are made in the installation of the system. Improvement Permit with plat valid without expiration. Improvement Permit with site plan valid for sixty months. Authorization to Construct is valid for a period equal to that of Improvement Permit - not to exceed sixty months.

Signed: Larry H Davis date 6/29/00

Improvement Permit by: C. Brady Lee RS date 11/9/99

Authorization to Construct by: C. Brady Lee RS date 6/27/00

Installed by: Richard Abernathy

Operation Permit by: Greg Mauldin RSI date 11/6/00

Existing System Inspection by: date

HEALTH DEPT. COPY WHITE OWNER COPY (FINAL) YELLOW OWNER COPY (INITIAL) PINK