IREDELL COUNTY HEALTH DEPARTMENT

STATESVILLE 704-878-5305 300.00 Paid MOORESVILLE 704-664-5281

IMPROVEMENT PERMIT / AUTHORIZATION TO CONSTRUCT / OPERATION PERMIT / EXISTING SYSTEM INSPECTION

PERMIT# -2- THOMAN PIN# 3-H-C-3 DATE 1/25/01

OWNER OR CONTRACTOR LARRY DAVIS PHONE: Business 664-9407 Home

ADDRESS 450 OAK TREE RD MOORESVILLE

LOCATION PERTH RD(S) - TL SPLEENWOOD - ON RT

SUBDIVISION SPLEENWOOD BLOCK / SECTION LOT 21 LOT AREA .85 AC SITE CLASS RS DESIGN FLOW 360 GPD L.T.A.R. 3 gpd/ft²

Septic Tank: 1000 Gallons: STB 10 12 Date 1-21-01
Pump Tank: Gallons: PT Date
Pump Make: Model Serial No.
Nitrification Field: No Fields 1 Square Feet 900 Linear Feet 300
No Lines 6@50' Trench Width 36" Max Trench Bottom Depth 36" Gravel Depth N/A

~~New System~~ Repair System Type: I II III IV V VI
System Description: GRAVITY 25% REDUCTION
Repair System Description: CP PANEL
Maintenance Agreement Required: Yes ~~No~~

~~House/Mod. Home~~ No. Bedrooms 3
Mobile Home No. Bathrooms 2
Business No. Employees
Other


Slab ~~Crawl Space~~ Basement w/plumbing Basement wo/plumbing

Water Supply: Individual ~~Public~~ Community


Comments/Conditions:

Comments/Conditions:
- Infiltrator Chambers Installed
- Septic Tank, Risers Installed
- Poly Lok filter Installed

INITIAL SITE SKETCH 1" = 50'

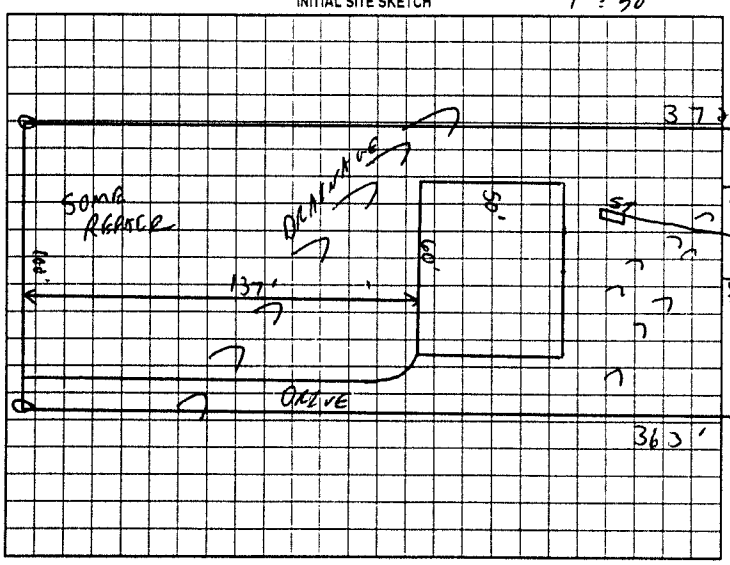

AS BUILT SKETCH

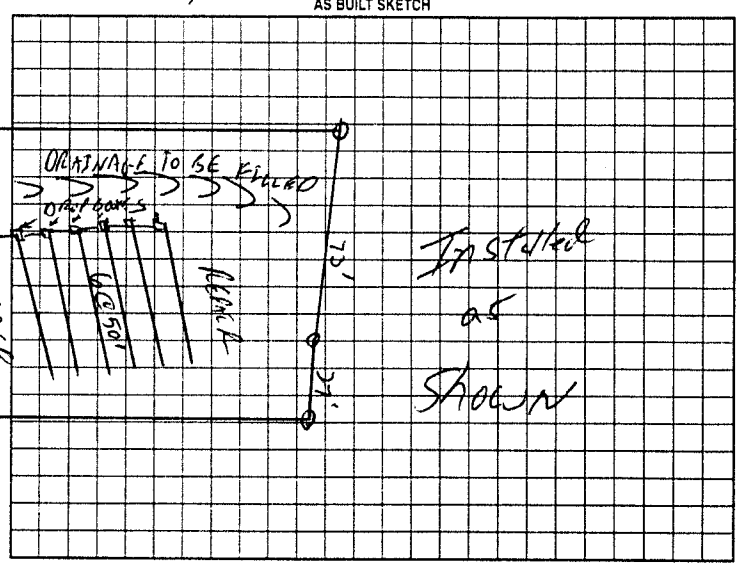

Permit can be suspended or revoked if any false information is supplied toward securing the permit/any unauthorized changes are made to the site/any unauthorized changes are made in the installation of the system. Improvement Permit with plan valid without expiration. Improvement Permit with site plan valid for sixty months. Authorization to Construct is valid for a period equal to that of Improvement Permit – not to exceed sixty months.

Signed: Larry H. Davis date 1/25/01

Improvement Permit by: C. [signature] RS date 1/25/01

Authorization to Construct by: C [signature] RS date 1/25/01

Installed by: Richard Abernathy

Operation Permit by: William O. Johnson date 8/30/01

Existing System Inspection by: date

HEALTH DEPT. COPY WHITE OWNER COPY (FINAL) YELLOW OWNER COPY (INITIAL) PINK