#106479

IREDELL COUNTY HEALTH DEPARTMENT

STATESVILLE 704-878-5305 300.00 Paid MOORESVILLE 704-664-5281

IMPROVEMENT PERMIT / AUTHORIZATION TO CONSTRUCT / OPERATION PERMIT / EXISTING SYSTEM INSPECTION

PERMIT# -2- TROUTMAN 106479 3 H-C-3

OWNER OR CONTRACTOR LARRY H. DAVIS PHONE: Business _____ Home _____ DATE 10/29/99

ADDRESS 430 OAK TREE RD. MOORESVILLE NC 28117

LOCATION PERTH RD(S) - TL SPICEWOOD - LOT ON RT

SUBDIVISION SPICEWOOD BLOCK / SECTION _____ LOT 25 LOT AREA .668 AC SITE CLASS P5 DESIGN FLOW 360 gal L.T.A.R. .3 gpd/ft²

Septic Tank: 1000 Gallons; STB 1012 Date 4/19/02

Pump Tank: 1000 Gallons; PT 7 Date 4/16/02

Pump Make: Little Giant Model 9EH Serial No. —

Nitrification Field: No Fields 1 Square Feet 900 Linear Feet 300

No Lines 4@75' Trench Width 36" Max Trench Bottom Depth 36" Gravel Depth N/A

☑ New System ☐ Repair System Type: I, II, III, IV, V, VI

System Description: PUMP 25% REDUCTION

Repair System Description: PUMP PANEL

Maintenance Agreement Required: ☐ Yes ☑ No

☑ House/Mod. Home No. Bedrooms 3

☐ Mobile Home No. Bathrooms 2

☐ Business No. Employees ____

☐ Other ____


☐ Slab ☑ Crawl Space ☐ Basement w/plumbing ☐ Basement wo/plumbing

Water Supply: ☐ Individual ☐ Public ☐ Community TROUTMAN ✓


Comments/Conditions: ① HOUSE SIZE INCREASED TO 50'x50' & CENTERED IN LOT WITH 25' on each side. HOUSE STILL HAS TO BE LOCATED 105' off front P/L with extra width of house going back in gully area as drawn.

Comments/Conditions ② LOOKED AT HOUSE PLANS ON 05-02-01 - CHECKED TANKS & 1ST LINE - 7/19/02 - wsf - Pole Lok Filter Installed, - 2nd & 4th Lines - okay - 7/23/02, 3rd Line okay, Pressure Checked okay - wsf

INITIAL SITE SKETCH 1"=50'

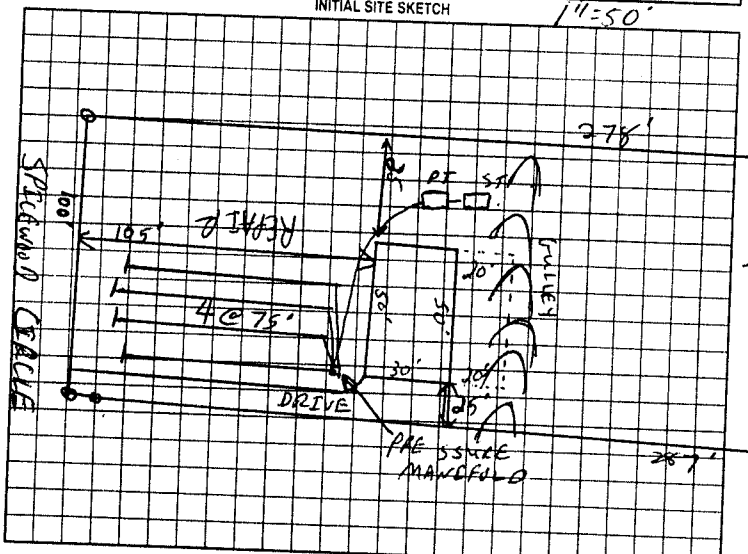

AS BUILT SKETCH

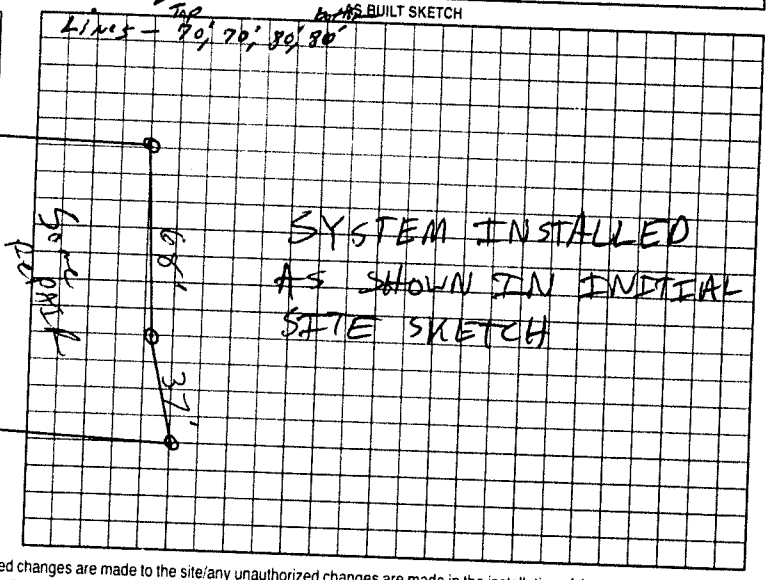

SYSTEM INSTALLED AS SHOWN IN INITIAL SITE SKETCH

Permit can be suspended or revoked if any false information is supplied toward securing the permit/any unauthorized changes are made to the site/any unauthorized changes are made in the installation of the system. Improvement Permit with plat valid without expiration. Improvement Permit with site plan valid for sixty months. Authorization to Construct is valid for a period equal to that of Improvement Permit – not to exceed sixty months.

Signed: Larry H Davis date 5/14/01

Improvement Permit by: C. Bob Dean RS date 10/29/99

Authorization to Construct by: Tim Cook RS date 05-62-02

Installed by: Richard Abernathy

Operation Permit by: Patrick Mitchell date 08/13/02

Existing System Inspection by: _____ date _____

HEALTH DEPT. COPY WHITE OWNER COPY (FINAL) YELLOW OWNER COPY (INITIAL) PINK