IREDELL COUNTY HEALTH DEPARTMENT

STATESVILLE 704-878-5305 CI MOORESVILLE 704-664-5281

IMPROVEMENT PERMIT / AUTHORIZATION TO CONSTRUCT / OPERATION PERMIT / EXISTING SYSTEM INSPECTION

123067

PERMIT# TROUTMAN68-2-07-04 PIN# 3H-C-3 / 4730-77-~~6836~~ 7156 DATE 6-22-04

OWNER OR CONTRACTOR MICHAEL M. QUICKEL PHONE: Business 704-745-0595 Home 704-723-6403 CELL

ADDRESS 312 UNION ST SOUTH P.O. BOX 1218 LOWELL N.C. 28034

LOCATION STATESVILLE RD SOUTH (L) SPICEWOOD (R) SPICEWOOD LOTS 12/13 ON RT IN CURVE

SUBDIVISION SPICEWOOD BLOCK / SECTION ____ LOT 12 & 13 LOT AREA .505AC + .51AC SITE CLASS. PS DESIGN FLOW 360 L.T.A.R. .25

Septic Tank: 1000 Gallons; STB 794 Date 5-10-04

Pump Tank: 1000 Gallons; PT 283 Date 6-9-04

Pump Make: ZOELLER Model N98 Serial No. ~~[illegible]~~

Nitrification Field: No Fields 1 Square Feet ED=1440 Linear Feet 360'

No Lines 4x90' Trench Width 36" Max Trench Bottom Depth 18"

☒ New System ☐ Repair System Type: I, II, (III) IV, V, VI

System Description: ☒ PUMP 25% REDUCTION

Repair System Description: SAME

Maintenance Agreement Required: ☐ Yes ☒ No

☒ House/Mod. Home No. Bedrooms 3

☐ Mobile Home No. Bathrooms 2

☐ Business No. Employees ____

☐ Other ____


Gravel Depth N/A ☐ Slab ☒ Crawl Space ☐ Basement w/plumbing ☐ Basement wo/plumbing


Water Supply: ☐ Individual ☒ Public ☐ Community

Comments/Conditions: (1) INITIAL & REPAIR ARE FLAGGED COMPLETELY (2) KEEP HOUSE CUT OF GROUND & BACKFILL FOR POSITIVE DRAINAGE SO 15' SETBACK CAN BE MAINTAINED (3) INSTALL LINES ON CONTOURS &

Comments/Conditions: MAINTAIN SETBACKS @ CALL PRIOR TO INSTALLATION FOR RIMPSIZING & SPECS. IF NECESSARY. USE A PRESSURE MANIFOLD FOR DISTRIBUTION. * SYSTEM SHALL BE HOS OR SPECIAL APPROVED SHALLOW PLACMENT, AS BUILT SKETCH CHAMBER FOR 12" TB WITH 6" COVER. LOT 12 & 13 MUST BE COMBINED BY AFFIDAVIT OR THIS PERMIT IS VOID (5) THIS PERMIT IS A REPAIR & ALL SOILS WORK WAS PREVIOUSLY DONE ON ORIGINAL VOIDED PERMIT DATED 11-16-99.

INITIAL SITE SKETCH 1" = 50'

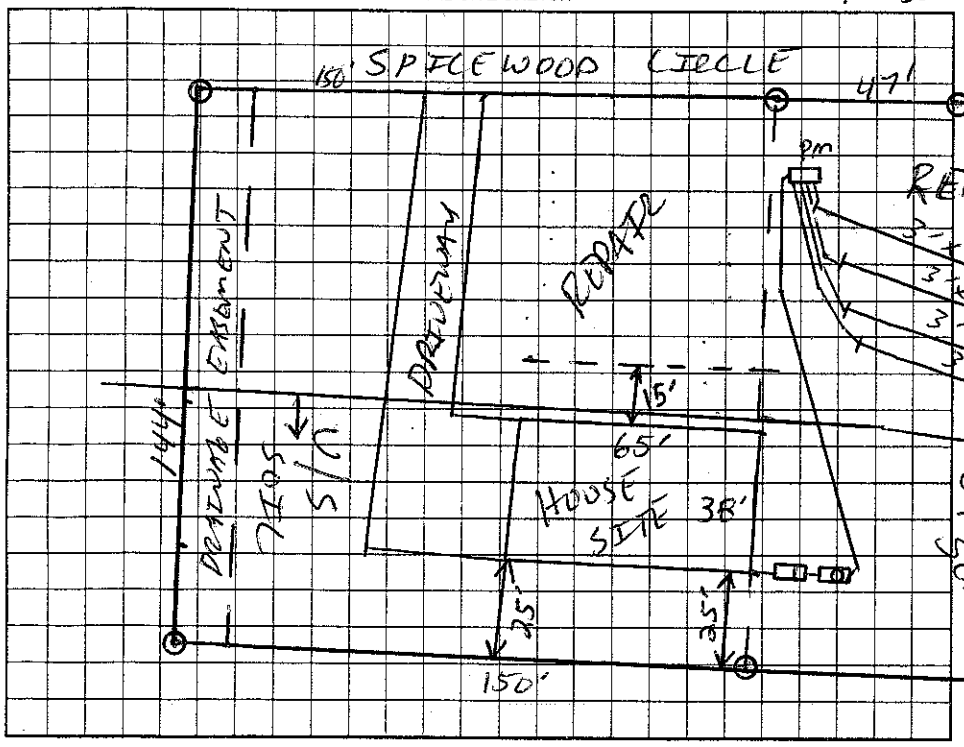

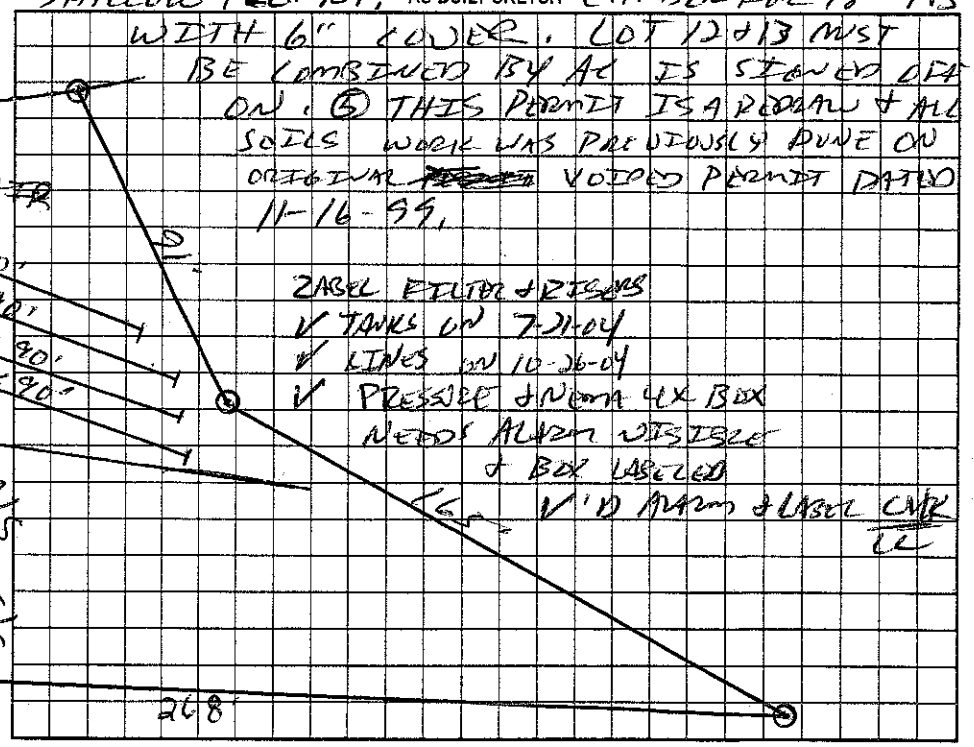

LABEL FILTER & RISERS
✓ TANKS ON 7-21-04
✓ LINES ON 10-26-04
✓ PRESSURE MANIFOLD 4X BOX NEEDS ALARM OUTSIDE & BOX LABELED
✓ V'D ALARM & LABEL CAP

Permit can be suspended or revoked if any false information is supplied toward securing the permit/any unauthorized changes are made to the site/any unauthorized changes are made in the installation of the system. Improvement Permit with plat valid without expiration. Improvement Permit with site plan valid for sixty months. Authorization to Construct is valid for a period equal to that of Improvement Permit – not to exceed sixty months.

Signed: ____ date 7/19/04 Installed by: ABERNATHY

Improvement Permit by: ____ date 6-22-04 Operation Permit by: ____ date 11-19-04

Authorization to Construct by: ____ date 7-19-04 Existing System Inspection by: ____ date ____

HEALTH DEPT. COPY: WHITE OWNER COPY (FINAL): YELLOW OWNER COPY (INITIAL): PINK