IREDELL COUNTY HEALTH DEPARTMENT

THIS PERMIT VOIDS PREVIOUS ISSUED 11-16-99

STATESVILLE 704-878-5305 (C) MOORESVILLE 704-664-5281

IMPROVEMENT PERMIT / AUTHORIZATION TO CONSTRUCT / OPERATION PERMIT / EXISTING SYSTEM INSPECTION

PERMIT# TRAUPMAN 115737 PIN# 3114-C-3 (PART) 4730-77-9127 DATE 8-16-03

OWNER OR CONTRACTOR MT INVESTMENTS / PETE MELETIS PHONE: Business 704-506-2922 Home

ADDRESS 1007 BRIARCUFF MOORESVILLE, NC 28115

LOCATION US 215, TR PERTH ROAD, TL SPICEWOOD, BEAR RIGHT SPICEWOOD CIRCLE, OUTSIDE 4TH CURVE ON (R)

SUBDIVISION SPICEWOOD BLOCK / SECTION LOT 14 LOT AREA 0.560 ACRE SITE CLASS PS DESIGN FLOW 360 L.T.A.R. 0.25 GPD/FT²

Septic Tank: 1000 Gallons; STB 312 Date 10-20-03
Pump Tank: 1000 Gallons; PT 27 Date 12-12-03
Pump Make: LITTLE GIANT Model 9EH-CIA-PFS Serial No.
Nitrification Field: No Fields 1 Square Feet 1440 Linear Feet 360
No Lines FOUR Trench Width 36" Max Trench Bottom Depth 36" Gravel Depth N/A

☑ New System ☐ Repair System Type: I, II, (III), IV, V, VI
System Description: 25% REDUCTION, PRIMP
Repair System Description: 50% REDUCTION, LOW PRESSURE
Maintenance Agreement Required: ☐ Yes ☑ No Other
☐ Slab ☑ Crawl Space ☐ Basement w/plumbing ☐ Basement wo/plumbing


☑ House/Mod. Home No. Bedrooms 3
☐ Mobile Home No. Bathrooms 2
☐ Business No. Employees

Water Supply: ☐ Individual ☑ Public ☐ Community


Comments:/Conditions: (1) INSTALL 25% REDUCTION SYSTEM ON CONTOUR AS SHOWN, (2) SEE ATTACHED SHEETS FOR PUMP & PRESSURE MANIFOLD REQUIREMENTS, (3) LOCATE WATER LINE AS SHOWN BELOW.

Comments:/Conditions: SEPTIC TANK WITH RISERS INSTALLED USING "POLYLOK" FILTER

INITIAL SITE SKETCH

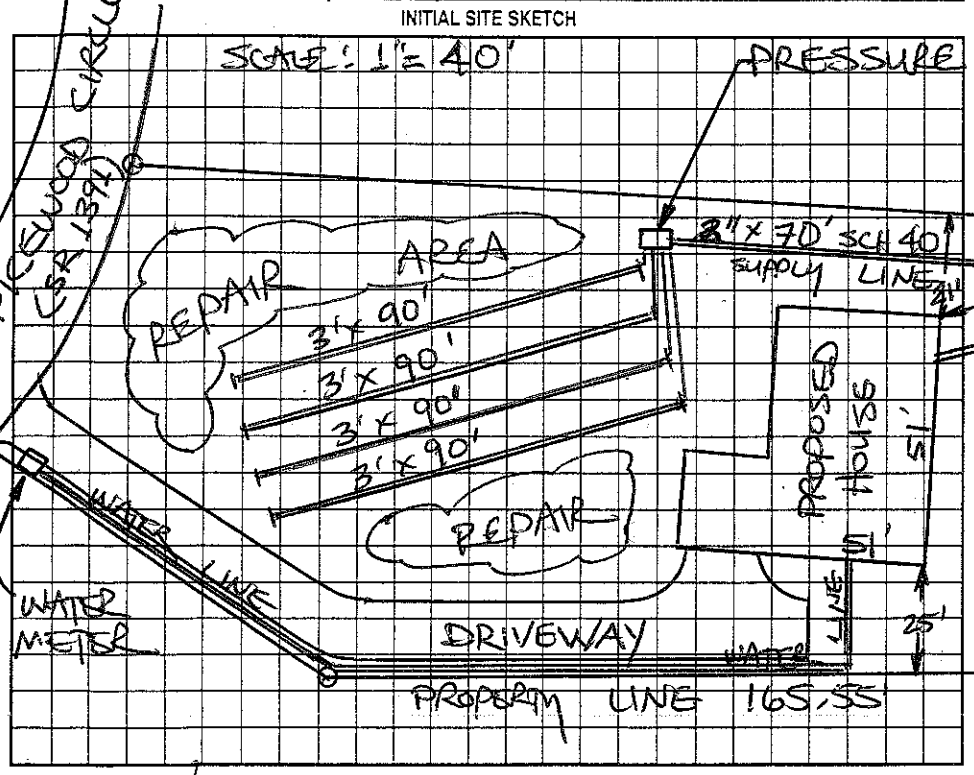

AS BUILT SKETCH — AS SHOWN

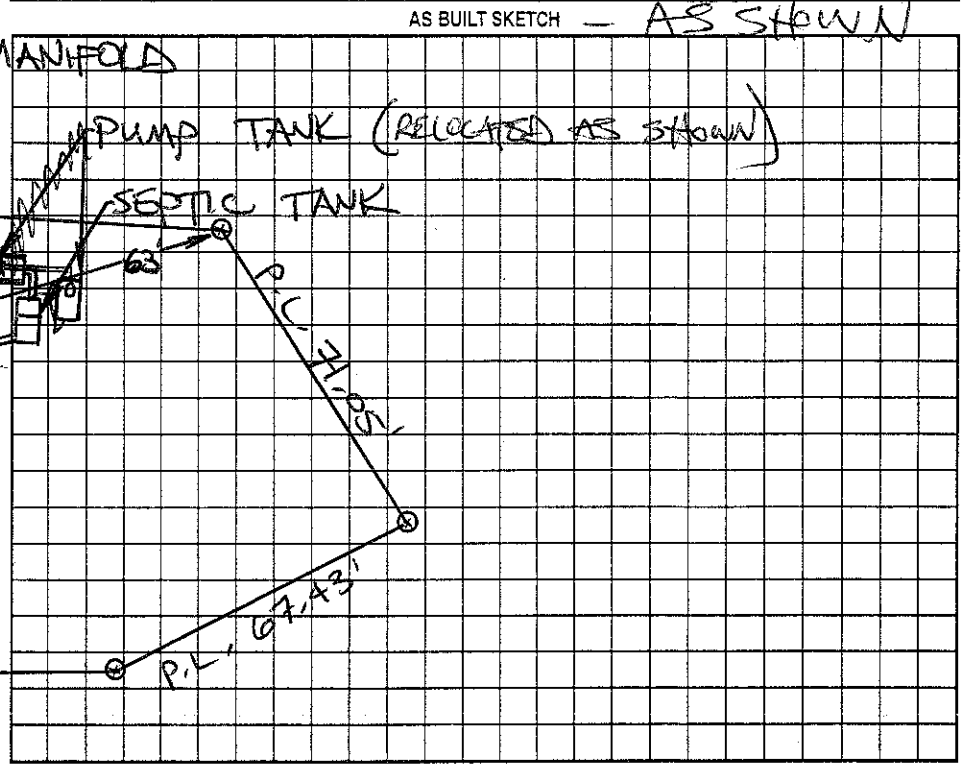

Permit can be suspended or revoked if any false information is supplied toward securing the permit/any unauthorized changes are made to the site/any unauthorized changes are made in the installation of the system. Improvement Permit with plat valid without expiration. Improvement Permit with site plan valid for sixty months. Authorization to Construct is valid for a period equal to that of Improvement Permit – not to exceed sixty months.

Signed: [signature] date 8-16-03 Installed by: RICHARD ABERNATHY

Improvement Permit by: STEVE HEDRICK date 8-16-03 Operation Permit by: STEVE HEDRICK date 2-20-04

Authorization to Construct by: STEVE HEDRICK date 8-16-03 Existing System Inspection by: date

HEALTH DEPT. COPY: WHITE OWNER COPY (FINAL): YELLOW OWNER COPY (INITIAL): PINK