IREDELL COUNTY HEALTH DEPARTMENT

THIS PERMIT VOIDS PREVIOUS ISSUED 11-15-99

STATESVILLE 704-878-5305 MOORESVILLE 704-664-5281

IMPROVEMENT PERMIT / AUTHORIZATION TO CONSTRUCT / OPERATION PERMIT / EXISTING SYSTEM INSPECTION

PERMIT# TROUTMAN 91477 PIN# 3H-C-3 DATE 8-9-00

OWNER OR CONTRACTOR QUICKEL DEVELOPMENT COMPANY PHONE: Business (704) 795-0595 Home

ADDRESS P.O. BOX 1218, CONCORD NC 28026

LOCATION US 21 S, TR PERTH RD, TL SPICEWOOD, TR SPICEWOOD CIRCLE, LOT #16 ON RIGHT

SUBDIVISION SPICEWOOD BLOCK / SECTION LOT 16 LOT AREA 0.507 ACRE SITE CLASS PS DESIGN FLOW 360 L.T.A.R. 0.3 GPD/FT²

Septic Tank: 1000 Gallons; STB 1012 Date 8/20/00
Pump Tank: Gallons; PT Date
Pump Make: Model Serial No.
Nitrification Field: No Fields 1 Square Feet 1200 Linear Feet 400
No Lines 4 Trench Width 36" Max Trench Bottom Depth 28" Gravel Depth 12"

☑ New System ☐ Repair System Type: I II III IV V VI
System Description: CONVENTIONAL GRAVITY
Repair System Description: LOW-PRESSURE PIPE (PPBPS)
Maintenance Agreement Required: ☐ Yes ☑ No


☑ House/Mod. Home No. Bedrooms 3
☐ Mobile Home No. Bathrooms 2
☐ Business No. Employees
☐ Other
☐ Slab ☑ Crawl Space ☐ Basement w/plumbing ☐ Basement wo/plumbing

Water Supply: ☐ Individual ☑ Public ☐ Community

Comments/Conditions:

Comments/Conditions: Polylok filter
Lower 3 lines OK 11/7/00 GM

INITIAL SITE SKETCH SCALE: 1"=40'

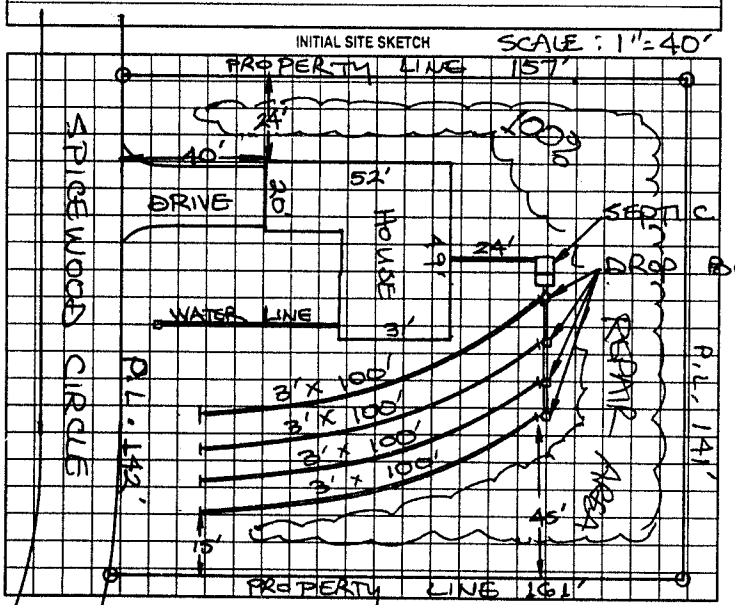

AS BUILT SKETCH

Permit can be suspended or revoked if any false information is supplied toward securing the permit/any unauthorized changes are made to the site/any unauthorized changes are made in the installation of the system. Improvement Permit with plat valid without expiration. Improvement Permit with site plan valid for sixty months. Authorization to Construct is valid for a period equal to that of Improvement Permit – not to exceed sixty months.

Signed: date 8/11/00 Installed by: Richard Abernathy

Improvement Permit by: STEVE HEDRICK date 8-9-00 Operation Permit by: RSI date 11/7/00

Authorization to Construct by: STEVE HEDRICK date 8-9-00 Existing System Inspection by: date

HEALTH DEPT. COPY: WHITE OWNER COPY (FINAL): YELLOW OWNER COPY (INITIAL): PINK