90451

IREDELL COUNTY HEALTH DEPARTMENT

STATESVILLE 704-878-5305 MOORESVILLE 704-664-5281

IMPROVEMENT PERMIT / AUTHORIZATION TO CONSTRUCT / OPERATION PERMIT / EXISTING SYSTEM INSPECTION

PERMIT# -Z- TROUTMAN PIN# 3H-C-3 DATE 4/5/00

OWNER OR CONTRACTOR LARRY H. DAVIS PHONE: Business 664-9407 Home

ADDRESS 450 OAK TREE RD. MOORESVILLE NC 28117

LOCATION 21 S. TR PERTH RD- T L SPICEWOOD - TR SPICEWOOD - R ON LT

SUBDIVISION SPICEWOOD BLOCK / SECTION LOT 32 LOT AREA .582AC SITE CLASS PS DESIGN FLOW 360 GPD L.T.A.R. .396/.432

Septic Tank: 1000 Gallons: STB 1017 Date 8-28-00
Pump Tank: Gallons: PT Date
Pump Make: Model Serial No.
Nitrification Field: No Fields 1 Square Feet 600 Linear Feet 200
No Lines 4@50' Trench Width 36" Max Trench Bottom Depth 36" Gravel Depth N/A

☒ New System ☐ Repair System Type: I. II. III. IV. V. VI
System Description: GRAVITY PANEL
Repair System Description: PUMP PANEL
Maintenance Agreement Required: ☐ Yes ☒ No
☐ Slab ☐ Crawl Space ☐ Basement w/plumbing ☐ Basement wo/plumbing


☒ House/Mod. Home No. Bedrooms 3
☐ Mobile Home No. Bathrooms 2
☐ Business No. Employees
☐ Other

Water Supply: ☐ Individual ☒ Public ☐ Community


Comments/Conditions: 1) KEEP SYSTEM 50' FROM NEIGHBOR'S WELL.

Comments/Conditions: ⊗ Neighbors well?

INITIAL SITE SKETCH 1"=50'

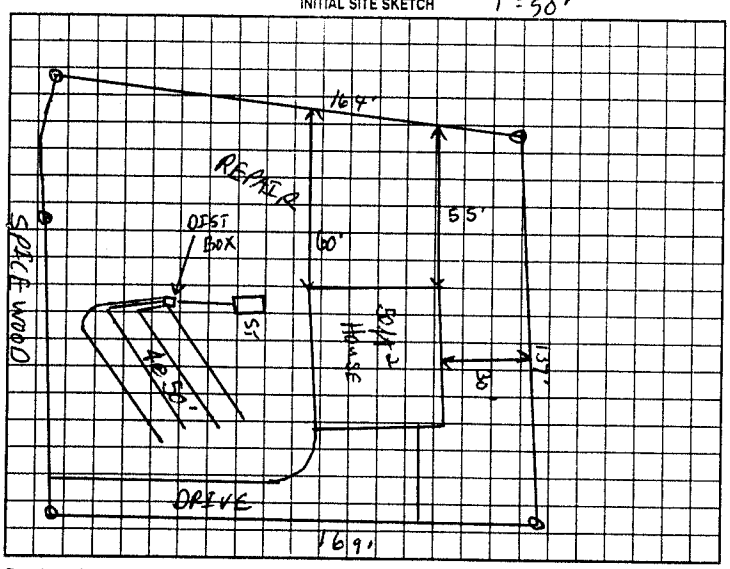

AS BUILT SKETCH

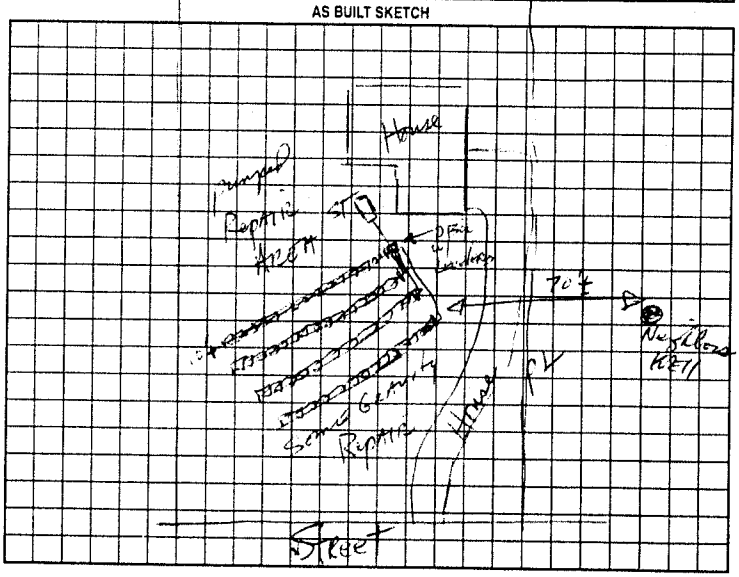

Permit can be suspended or revoked if any false information is supplied toward securing the permit/any unauthorized changes are made to the site/any unauthorized changes are made in the installation of the system. Improvement Permit with plat valid without expiration. Improvement Permit with site plan valid for sixty months. Authorization to Construct is valid for a period equal to that of Improvement Permit – not to exceed sixty months.

Signed: Larry Davis date 4/5/00

Improvement Permit by: C. [illegible] KS date 4/5/00

Authorization to Construct by: C. [illegible] KS date 6/30/00

Installed by:

Operation Permit by: [illegible] date 10-20-00

Existing System Inspection by: date

HEALTH DEPT. COPY: WHITE OWNER COPY (FINAL): YELLOW OWNER COPY (INITIAL): PINK